

Fori — Sprint 2 WK1 Developer Redline Annotations

Built-state documentation of the "Bushfire Prototype Sprint 1 WK3" prototype. Audit and annotation only — no design changes were made.

- Source artefact: Bushfire Prototype Sprint 1 WK3 (single artefact; no other version was opened or referenced).
- Captured in the default dark theme at a 1440 px-wide viewport, with each screen unclipped to its full scroll height so every state fits in one image.
- Annotation convention: every distinct visual element carries its own number. There are no collapsed ranges — each badge on a figure has exactly one table row, and each table row points at exactly one badge.
- Numbered badges are an annotation overlay added for this document. They are not part of the prototype. Each badge is placed in clear space beside its element — never over text — with a thin leader line drawn whenever the badge had to sit further away; the strip down the right-hand edge of each figure is annotation margin, not part of the screen.
- Toasts are fixed at top right (64 px / 20 px) in the running app. In figures they are shown at the foot of the screen so they do not cover the UI underneath; the table states the real position.
- "Visual spec" values are read from the running prototype (computed styles), not from intent. Token names in brackets are the prototype's own CSS variables.

1 · Phase 1 audit — present / partial / missing

Reported against the "Bushfire Prototype Sprint 1 WK3" artefact only. Findings are recorded as built; nothing here was resolved or redesigned. Everything marked partial or missing is carried forward into section 4, Open items.

1. Manual Review — required elements

Item	Status	Reason
Empty state	Present	"Nothing awaiting review" block with threshold sentence, shown when the queue is clear
Flagged-image loaded state	Present	Left queue rail + image placeholder, AI provisional tag, element scores, flag reason
Three action buttons	Partial	Confirm and Discard are single buttons; "Change" is four severity chips (CAT/EXT/HIGH/MOD), not one button. Two extra actions exist — "Request second image" and "Locate on map" — so the screen has five reviewer controls, not three
Confidence score visible	Present	Shown twice: 0.34 in the banner and again next to the provisional tag, both against the 0.75 threshold
Flagging reason visible	Present	"REASON FOR FLAGGING" panel: prose reason, three bullets, and the withheld provisional score

2. Manual Review — immediately after each action

Action	Status	Reason
Confirm	Present	Applies the provisional band, navigates away to Incident Detail, toast "AI tag confirmed", flag → Processed, log entry written
Change	Present	Same pattern via a severity chip: applies level, navigates to Incident Detail, toast "Severity assigned manually", flag → Processed
Discard	Partial	Stays on Manual Review, queue advances to the next item (or empty state), toast "Discarded as not a fire" with Undo. Inconsistent with Confirm/Change, which both leave the screen — no on-screen confirmation that the record moved to Archive other than the toast

3. Incident Detail

Item	Status	Reason
Four severity sub-scores	Present	"HOW THIS SEVERITY WAS SCORED": Smoke / Flame visibility / Damage-impact / People proximity, each 1–4 with a filled cell strip, total /16, band map. Caveat: a coordinator-assigned severity shows all four as "— not scored"
Source channel	Present	"input source" chip in the header (MANUAL/DRONE/SAT/API) plus src= in the exportable record
Incident group ID	Present	"INCIDENT GROUP ID" field: GRP-04, GRP-04 (unconfirmed), or none
Classification label	Present	"CLASSIFICATION LABEL" field resolving to Fire / Non-Fire / Extinguished / Uncertain
Priority	Present	"PRIORITY" field: #n of m, live · crew dispatched, not ranked, resolved · not ranked

4. Map

Item	Status	Reason
Default zoom clustering	Partial	Default load is Z2, whose only defined cluster is INC-0428 + INC-0435; INC-0435 is flagged and never drawn, so the cluster drops below two members and no cluster renders at default zoom. Clusters only appear at Z1
Cluster expansion on zoom	Present	Clicking a cluster increments zoom; +/- buttons; Z3 renders every marker individually

Item	Status	Reason
Marker colour/number pairing	Present	Number = severity level 1–4, fill/ring from the band palette, border weight grows 2→4px, diameter 26→50px; the legend repeats the same pairing

5. Archive / Resolved

Item	Status	Reason
Dismissed (Not a Fire) presentation	Present	Own screen, grey DISMISSED chip, why-dismissed text, decided-by (AI gate vs coordinator), Restore action
Distinguishable from resolved	Partial	They are separate screens with different chips (DISMISSED vs EXTINGUISHED) and tab badge colours, but both chips use the same --surface-3 fill and differ only by border and text colour — weak separation if the two lists are ever merged

6. Dispatch states

Item	Status	Reason
Awaiting vs Live	Present	Awaiting: accent section bar, numeric rank, solid accent "Dispatch" button. Live: green section bar, rank column reads "LIVE", outline "Extinguished" button
Transition trigger	Present	"Dispatch" on the row or "Dispatch crew" on detail pushes the id into dispatched; the row moves sections; toast "Tanker 12 en route". Note: the row's "Dispatched" green button state is unreachable because the row relocates immediately

7. Override

Item	Status	Reason
Toast auto-dismiss ~5s	Present	5s timer plus a 5s draining progress bar and "clears in 5s · dismiss sooner with ✕"
Undo placement	Partial	Two places: "Undo" CTA in the toast, and an inline "Undo · back to AI level n" beside the override chips — but the inline Undo only appears for a plain override, not after a Confirm or a manual assignment, so those are undoable only within the toast's 5 seconds
Log visible in UI	Partial	"DECISION LOG" on Incident Detail shows what / who / when for that incident only. There is no cross-incident audit view anywhere

8. Incident grouping

Item	Status	Reason
Propose / confirm / split	Present	"GROUPING SUGGESTION" card in Alerts & Suggested: AWAITING CONFIRMATION → Confirm as one incident / Keep separate; once confirmed → Split into separate incidents. Mirrored as a banner on member incidents' detail screens. Never auto-commits
Completeness	Partial	One hardcoded group (GRP-04, three members); split is all-or-nothing with no member-level de-selection; opening the panel hides the active incident list

2 · Design tokens reference

Two complete palettes ship in the prototype: dark (the default) and light, switched by the DARK / LIGHT control in the header and remembered in localStorage under key "firesight-theme". Every value below is the built value. All annotations in section 2 use the dark palette.

Type

Item	Built value	Where it is used
Families	IBM Plex Sans (400, 500, 600, 700); IBM Plex Mono (400, 500, 600, 700). Loaded from Google Fonts. Body fallback: system-ui, sans-serif.	Sans for prose, place names, descriptions. Mono for every label, ID, number, chip, button and metric.
Screen titles	Sans 600, 22 px / 1.2, letter-spacing .08em, uppercase	Dispatch Order, Archive · Not a Fire, Resolved · Extinguished, Submit Field Image
Severity headline	Sans 600, 24 px (detail) / 22 px (review banner), .06-.08em, uppercase	CATASTROPHIC, FLAGGED FOR MANUAL REVIEW
Section labels	Mono 600, 10 px, letter-spacing .16em, uppercase	OVERRIDE SEVERITY, DECISION LOG, REASON FOR FLAGGING, table column heads (.14em)
Field labels	Mono 600, 10 px, .12-.16em, uppercase, colour muted	GEOTAG, PRIORITY, INCIDENT GROUP ID
Field values	Mono 500-600, 13-14 px	coordinates, times, classification label, priority
Buttons	Mono 600, 11 px, letter-spacing .12em, uppercase (small/row buttons: 10 px, .1-.12em)	all actions
Body prose	Sans 400, 13.5 px / 1.55 (secondary 12.5 px / 1.4; "why this position" 13.5 px / 1.45; summary 15 px / 1.55)	reasons, summaries, descriptions
Numbers	Mono 700 – 25 px (detail severity), 20-22 px (confidence, total score), 16 px (element score), 22 px 600 (rank)	severity dot, 0.92, 16, rank 1
Smallest type in use	Mono 700, 9 px, .12-.14em, uppercase – severity abbreviation chips (CAT/EXT/HIGH/MOD), STEP 1/2, DISMISSED, EXTINGUISHED	flag as an accessibility risk: 9 px is below a comfortable minimum for a control-room display

Severity bands (the four colour pairs)

Item	Built value	Where it is used
1 · Moderate (sum 4–7)	Fill #F5C842, text #1A1405, ring #FFE08A 2 px, dot 26 px, numeral 12 px	Marker, legend, chips, band map. Abbreviation MOD.
2 · High (sum 8–10)	Fill #F58021, text #1A0C02, ring #FFB36B 2 px, dot 34 px, numeral 15 px	Abbreviation HIGH.
3 · Extreme (sum 11–13)	Fill #E03127, text #FFFFFF, ring #FF8078 3 px, dot 42 px, numeral 18 px	Abbreviation EXT.
4 · Catastrophic (sum 14–16)	Fill #7A0F16, text #FFFFFF, ring #FF4D4D 4 px, dot 50 px, numeral 21 px	Abbreviation CAT. Detail-header dot is 56 px with a 4 px ring and a 4 px --halo outer ring.
Flagged for review (no band)	Fill accent @10%, text/ring #2BD9C8, 2 px dashed, dot 34 px, numeral "?"	Review queue, order rows, toast. Never drawn on the map.
Dismissed / not a fire	Fill #16202A (--surface-3), text #8B9AA8, 1 px #42525F, numeral "0"	Archive chip and dismissal toast.
Light-theme rings	sev1 #7A5300, sev2 #8A4103, sev3 #A3231A, sev4 #6B0D13 (fills unchanged)	Rings darken in light theme; the four fills are identical in both themes.

Dark palette (default)

Item	Built value	Where it is used
Page / header / map	--bg #080B0F · --bg-header #05080B · --map-bg #0A1016 · --halo #0A1016	app background, header bar, map canvas, marker halo ring
Surfaces	--panel #0C1219 · --surface #0A0F15 · --surface-2 #131C25 · --surface-3 #16202A · --surface-4 #121A22 · --input-bg #080D12	cards, table headers, hover rows, chips, inputs
Accent tints	--tint #101A22 · --tint-2 #101B22 · accent alphas at 2%, 6%, 7%, 8%, 10%, 12%, 14%, 28%, 55%	selected rows, hatch fills, note strips, button hovers
Text	--fg #E6EDF3 · --fg-2 #C4D0DA · --fg-3 #D5DFE8 · --fg-4 #A8B6C2 · --muted #8B9AA8 · --faint #5C6B77 · --faint-2 #3D4A56	headings → separators
Borders	--border #1F2A35 · --border-2 #2C3A48 · --border-3 #26333F · --border-4 #22303C · --border-5 #161F28 · --border-6 #1B2731 · --border-7 #42525F	1 px hairlines; -5 for row dividers, -7 for the strongest outline
Accent	--accent #2BD9C8 · --accent-hi #7FEFE3 (hover) · --accent-deep #17A093 (active) · --on-accent #04191A · --accent-border #1D5B57 · --accent-fg #9FE9E0	primary action, selection, all "needs your decision" states
Status	--ok-fg #5FD98C · --ok-border #1E6B3D · green tints 6/9/10% · --conf-high #35C46A · --conf-mid #F5C842	dispatched / live / resolved, confidence bars
Error	--err-fg #FF8C82 · --err-fg-2 #C9A6A1 · --err-bg #1A0C0B · --err-border #4A1E1A · hard stop #E03127	submission rejection, required-field state
Shadow	rgba(0,0,0,.6) — markers 0 3px 10–12px, toast 0 8px 30px, modal 0 20px 60px	only elevation cue in the design

Light palette (alternate)

Item	Built value	Where it is used
Page / surfaces	--bg #EEF1F5 · --panel #FFFFFF · --surface #F6F8FA · --surface-2 #E9EEF3 · --surface-3 #DFE6ED · --map-bg #E7ECF1	same roles as dark
Text / borders	--fg #0E1720 · --fg-2 #2E3C49 · --muted #55636F · --faint #7C8A96 · --border #CFD8E0 · --border-2 #B7C3CD · --border-7 #A9B6C0	same roles as dark
Accent	--accent #0A7268 · --accent-hi #065048 · --on-accent #FFFFFF · --accent-border #7FC5BC	darker teal for contrast on white
Header exception	The header keeps a dark ground in light theme: #12243D with --accent #3FE0CE and --fg #F2F6FA	header is the only inverted region in light theme
Status	--ok-fg #136B39 · --ok-border #8FCCA6 · --conf-high #136B39 · --conf-mid #B45309 · --err-fg #A8241C	same roles as dark

Geometry, spacing, motion

Item	Built value	Where it is used
Corner radius	0 px on every panel, card, chip, button, input and table. The only curves in the build are border-radius 50% circles (severity dots, cluster badges, "?" hint buttons, toast icon and close control) and the organic map terrain shapes (percentage radii).	square-cornered system; do not introduce rounded cards
Border weight	1 px hairlines everywhere; 2 px dashed for "awaiting a human decision"; 3 px solid left mark on the selected review-queue row; severity rings 2/2/3/4 px by band	dashed = undecided, solid = decided
Header	52 px tall, 1 px bottom border, sections divided by 1 px vertical rules; logo mark 20×20 accent square; avatar 26×26	fixed height, never scrolls
Card padding	15-16 px vertical / 18 px horizontal (cards); 11-14 px / 13-22 px (rows and banners); 20-22 px (detail columns); screens 20 px top / 24 px sides / 40 px bottom	
Gaps	Layout stacks use 16 px; inner groups 8-14 px; chip rows 6-8 px; table column gap 14 px	
Grids	Map 1fr / 372 px · Manual Review 308 px / 1fr · Incident Detail 308 px / 1fr · Dispatch Order 52 / 58 / 1fr / 1.5fr / 96 / 74 / 128 px · Archive and Resolved 7-column auto grids	
Responsive rules	Header clock and LIVE counter appear at ≥1420 px; keyboard-shortcut and  controls at ≥1280 px; full tab labels ("Dispatch Order", "Manual Review", "Submit Image") at ≥1240 px, shortened below; tab padding 14 → 10 → 8 px at 1100 / 960 px	six tabs must always fit without hiding any
Motion	Colour and background transitions .12 s; map zoom transform .25 s ease; marker hover scale 1.08-1.14; @keyframes pulseRing 1.6 s ×3 on a newly inserted marker; spin .7 s (processing); barSlide .8 s (progress); toastBar 5 s linear scaleX(1→0)	no other animation in the build
Focus treatment	2 px solid --accent outline with 2-3 px offset on every focusable control; focus is suppressed for non-keyboard focus ([tabindex]:focus:not(:focus-visible))	keyboard operability is built in: Tab, Enter/Space on all div-buttons, ←/→ to change screen, Alt/Option+1-6 to jump, ? for the shortcut sheet, Esc to close


3 · Screens

Submit Image

Tab 6 of 6, titled "Submit Field Image" in the screen body. Single centred column, max-width 720px, on --bg. Three stacked cards: the submission-flow tracker, the form itself (image, geotag, capture time, notes) and the action bar, followed by four dashed demo buttons that drive the prototype states. Four distinct states are documented: empty form, populated form, rejected submission (geotag missing) and submission confirmed / assessment running. Every image runs the fire / not-fire gate first, then severity scoring; geotag and capture time are mandatory.

Figure 1 — State 1 — empty form (default entry state)

Reached from the SUBMIT IMAGE tab. No file attached, all three required fields empty, all four flow steps "waiting".

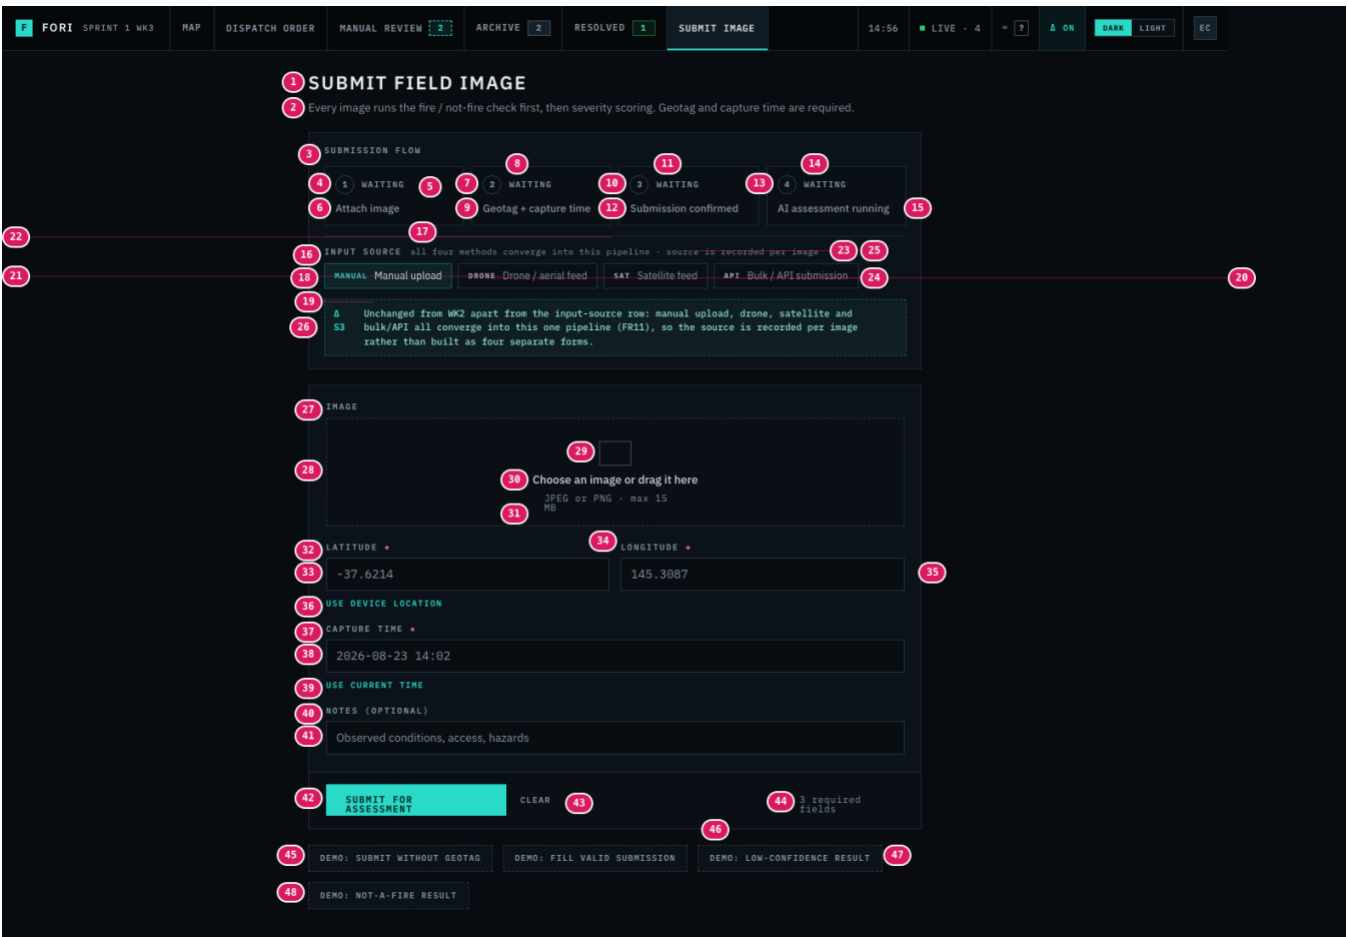

#	Element	Visual spec	Behaviour / interaction
1	Screen title — "Submit Field Image"	Sans 600 22px/1.2, .08em, uppercase · #E6EDF3	Static.
2	Screen description	Sans 400 13.5px/1.5 · #8B9AA8	States the pipeline order (fire / not-fire check first, then severity scoring) and that geotag and capture time are required.
3	"SUBMISSION FLOW" card heading	Mono 600 10px, .16em, uppercase · #8B9AA8	Section label on a --panel card, 1px solid #1F2A35, 16/18px padding.
4	Step 1 marker — "1"	21px circle · Mono 700 10px · #8B9AA8, no fill, 1px solid #2C3A48	Read-only progress marker. waiting → done (✓) as the step completes; the running step shows a filled • dot.

#	Element	Visual spec	Behaviour / interaction
5	Step 1 state word — "waiting"	Mono 600 10px, .12em, uppercase · #8B9AA8	Derived from the form state; not clickable.
6	Step 1 label — "Attach image"	Sans 500 12.5px · #8B9AA8	Static label. Turns from #8B9AA8 to #E6EDF3 once the step is done or running.
7	Step 2 marker — "2"	Same as #4	Read-only progress marker. waiting → done (✓) as the step completes; the running step shows a filled • dot.
8	Step 2 state word — "waiting"	Same as #5	Derived from the form state; not clickable.
9	Step 2 label — "Geotag + capture time"	Same as #6	Static label. Turns from #8B9AA8 to #E6EDF3 once the step is done or running.
10	Step 3 marker — "3"	Same as #4	Read-only progress marker. waiting → done (✓) as the step completes; the running step shows a filled • dot.
11	Step 3 state word — "waiting"	Same as #5	Derived from the form state; not clickable.
12	Step 3 label — "Submission confirmed"	Same as #6	Static label. Turns from #8B9AA8 to #E6EDF3 once the step is done or running.
13	Step 4 marker — "4"	Same as #4	Read-only progress marker. waiting → done (✓) as the step completes; the running step shows a filled • dot.
14	Step 4 state word — "waiting"	Same as #5	Derived from the form state; not clickable.
15	Step 4 label — "AI assessment running"	Same as #6	Static label. Turns from #8B9AA8 to #E6EDF3 once the step is done or running.
16	"INPUT SOURCE" label	Same as #3	Section label above the channel row, separated by a 1px --border top rule with 13px padding.
17	Input-source note	Mono 400 10px, .04em · #8B9AA8	"all four methods converge into this pipeline · source is recorded per image" — states FR11 behaviour in the interface.
18	Input-source abbreviation — MANUAL	Mono 700 9px, .12em · #2BD9C8 · chip 1px solid #1D5B57 on --tint #101A22 · 8/11px pad	Marks the channel this form represents. The chip is a static indicator, not a selector — all four channels converge on one pipeline and the source is stamped per image.
19	Input-source name — "Manual upload"	Sans 400 12px · #E6EDF3	Static.
20	Input-source abbreviation — DRONE	Mono 700 9px, .12em · #A8B6C2 · chip 1px solid #26333F on --panel #0C1219 · 8/11px pad	Shown to state that this channel exists and lands in the same pipeline. Not selectable in the prototype.
21	Input-source name — "Drone / aerial feed"	Sans 400 12px · #8B9AA8	Static.
22	Input-source abbreviation — SAT	Same as #20	Shown to state that this channel exists and lands in the same pipeline. Not selectable in the prototype.
23	Input-source name — "Satellite feed"	Same as #21	Static.
24	Input-source abbreviation — API	Same as #20	Shown to state that this channel exists and lands in the same pipeline. Not selectable in the prototype.
25	Input-source name — "Bulk / API submission"	Same as #21	Static.

#	Element	Visual spec	Behaviour / interaction
26	Δ S3 change note	Mono 500 11px/1.5 · #9FE9E0 on accent @6% · 1px dashed #1D5B57 · "Δ S3" marker Mono 700 11px #2BD9C8	Prototype commentary, not product UI. Toggled by the header Δ ON/OFF control (showChangeNotes prop).
27	"IMAGE" field label	Same as #3	Static.
28	Image drop zone (button)	678×128px · 1px dashed #2C3A48 · --surface #0A0F15 · 26px pad · hover border #2BD9C8, bg --tint-2 · focus 2px accent outline at 2px offset	Click or drag-and-drop attaches an image. In the prototype the click is simulated: it fills the file name IMG_4475.jpg and switches the zone to its filled treatment (state 2). No real file picker opens.
29	File-type glyph	38×30px box · 1px solid #42525F · no fill	Decorative placeholder for the image thumbnail.
30	Drop-zone primary text — "Choose an image or drag it here"	Sans 500 13.5px · #D5DFE8	Replaced by the file name once a file is attached.
31	Drop-zone hint — "JPEG or PNG · max 15 MB"	Mono 400 11px, .06em · #8B9AA8	Replaced by "2.4 MB · JPEG · tap to replace" once attached. The 15 MB limit is not enforced in the prototype.
32	"LATITUDE *" label	Mono 600 10px, .12–.16em, uppercase · #8B9AA8 · asterisk #FF8C82	The asterisk marks a required field. One of three.
33	Latitude input	332×38px · Mono 400 14px · #E6EDF3 on --input-bg #080D12 · 1px solid #26333F · 0/11px pad · placeholder "-37.6214"	Free-text entry. Typing clears any active error state. Empty on submit → the form is rejected with the geotag error (state 3).
34	"LONGITUDE *" label	Same as #32	Required.
35	Longitude input	332×38px · same treatment as #33 · placeholder "145.3087"	Same behaviour as latitude; both are validated together as "geotag".
36	"Use device location" action	Mono 600 10px, .12em, uppercase · #2BD9C8 · hover #7FEFE3 · focus 2px accent outline at 3px offset	Fills latitude and longitude with the device coordinates in one click (prototype: writes fixed coordinates).
37	"CAPTURE TIME *" label	Same as #32	Required.
38	Capture-time input	678×38px · same treatment as #33 · placeholder "2026-08-23 14:02"	Free-text entry. Empty on submit → rejected with the capture-time error. Geotag is validated first, so if both are missing the geotag error is the one shown.
39	"Use current time" action	Mono 600 10px, .12em, uppercase · #2BD9C8	Fills the capture-time field with the current clock value.
40	"NOTES (OPTIONAL)" label	Mono 600 10px, .12–.16em, uppercase · #8B9AA8	The only optional field.
41	Notes input	678×38px · Sans 400 13.5px · #E6EDF3 on --input-bg · 1px solid #26333F · placeholder "Observed conditions, access, hazards"	Free text. Not validated and not shown anywhere else in the prototype.
42	"Submit for assessment" primary button	Mono 600 11px, .12em, uppercase · #04191A on #2BD9C8 · 1px solid #2BD9C8 · 12/22px pad · hover #7FEFE3 · active #17A093	Validates geotag then capture time. Missing either → state 3 (no submission made). Both present → state 4: submitState becomes "processing", the button relabels to "Assessing image..." with a spinner and stops accepting clicks, and after the processing delay the new incident is inserted and the app navigates to the Map (or to the Archive when the result is not-a-fire), with a toast naming the outcome.
43	"Clear" action	Mono 600 10px, .12em, uppercase · #8B9AA8 · hover #E6EDF3	Empties all four fields, drops the attached file and clears any error state. No confirmation.
44	Status hint — "3 required fields"	Same as #31	Static count while idle; becomes "do not close this tab" while processing.
45	Demo button — "Demo:	Mono 600 10px, .12em, uppercase · #8B9AA8 on --	Prototype control, not product UI: loads a file with

#	Element	Visual spec	Behaviour / interaction
	submit without geotag"	panel · 1px dashed #2C3A48 · 8/11px pad	the geotag missing and puts the form straight into the rejected state (state 3).
46	Demo button — "Demo: fill valid submission"	Same as #45	Fills the form with a valid submission (state 2).
47	Demo button — "Demo: low-confidence result"	Same as #46	Fills the form and arms the next submission to return a below-threshold result, which routes the new image to Manual Review instead of the map.
48	Demo button — "Demo: not-a-fire result"	Same as #46	Fills the form and arms the next submission to return a not-a-fire result, which lands in the Archive.

Figure 2 — State 2 — form populated and valid

After attaching an image and entering geotag and capture time. Steps 1 and 2 read "done"; the submit button is unchanged. Only the elements that differ from state 1 carry new behaviour; the remainder repeat state 1 exactly.

The screenshot shows the 'SUBMIT FIELD IMAGE' form in State 2. The form is titled 'SUBMIT FIELD IMAGE' and includes a description: 'Every image runs the fire / not-fire check first, then severity scoring. Geotag and capture time are required.' The form is divided into several sections: 'SUBMISSION FLOW', 'INPUT SOURCE', 'IMAGE', 'LATITUDE', 'LONGITUDE', 'USE DEVICE LOCATION', 'CAPTURE TIME', 'USE CURRENT TIME', 'NOTES (OPTIONAL)', and 'SUBMIT FOR ASSESSMENT'. The 'SUBMISSION FLOW' section shows a progress bar with steps 1 through 15. Steps 1 and 2 are marked as 'DONE'. The 'INPUT SOURCE' section shows four methods: 'MANUAL - Manual upload', 'DRONE - Drone / aerial feed', 'SAT - Satellite feed', and 'API - Bulk / API submission'. The 'IMAGE' section shows a preview of the image 'IMG_4475.jpg' with a size of 2.4 MB and a format of JPEG. The 'LATITUDE' and 'LONGITUDE' fields are populated with '-37.6188' and '145.3352' respectively. The 'CAPTURE TIME' field is populated with '2026-08-23 14:16'. The 'SUBMIT FOR ASSESSMENT' button is highlighted in red. The form also includes a 'CLEAR' button and a '3 required fields' error message. The bottom of the form features four buttons: 'DEMO: SUBMIT WITHOUT GEOTAG', 'DEMO: FILL VALID SUBMISSION', 'DEMO: LOW-CONFIDENCE RESULT', and 'DEMO: NOT-A-FIRE RESULT'.

#	Element	Visual spec	Behaviour / interaction
1	Screen title	As state 1 #1	Static.
2	Screen description	As state 1 #2	Static.
3	"SUBMISSION FLOW" heading	Mono 600 10px, .16em, uppercase · #8B9AA8	Static.
4	Step 1 marker — "✓"	21px circle · Mono 700 10px · #04190C on #35C46A, 1px solid #35C46A	Read-only progress marker. waiting → done (✓) as the step completes; the running step shows a filled • dot.
5	Step 1 state word — "done"	Mono 600 10px, .12em, uppercase · #5FD98C	Derived from the form state; not clickable.
6	Step 1 label — "Attach image"	Sans 500 12.5px · #E6EDF3	Static label. Turns from #8B9AA8 to #E6EDF3 once the step is done or running.
7	Step 2 marker — "✓"	Same as #4	Read-only progress marker. waiting → done (✓) as the step completes; the running step shows a filled • dot.
8	Step 2 state word — "done"	Same as #5	Derived from the form state; not clickable.
9	Step 2 label — "Geotag + capture time"	Same as #6	Static label. Turns from #8B9AA8 to #E6EDF3 once the step is done or running.
10	Step 3 marker — "3"	21px circle · Mono 700 10px · #8B9AA8, no fill, 1px solid #2C3A48	Read-only progress marker. waiting → done (✓) as the step completes; the running step shows a filled •

#	Element	Visual spec	Behaviour / interaction
			dot.
11	Step 3 state word — "waiting"	Mono 600 10px, .12em, uppercase · #8B9AA8	Derived from the form state; not clickable.
12	Step 3 label — "Submission confirmed"	Sans 500 12.5px · #8B9AA8	Static label. Turns from #8B9AA8 to #E6EDF3 once the step is done or running.
13	Step 4 marker — "4"	Same as #10	Read-only progress marker. waiting → done (✓) as the step completes; the running step shows a filled • dot.
14	Step 4 state word — "waiting"	Same as #11	Derived from the form state; not clickable.
15	Step 4 label — "AI assessment running"	Same as #12	Static label. Turns from #8B9AA8 to #E6EDF3 once the step is done or running.
16	"INPUT SOURCE" label	Same as #3	Static.
17	Input-source note	As state 1 #17	Static.
18	Input-source abbreviation — MANUAL	Mono 700 9px, .12em · #2BD9C8 · chip 1px solid #1D5B57 on --tint #101A22 · 8/11px pad	Marks the channel this form represents. The chip is a static indicator, not a selector — all four channels converge on one pipeline and the source is stamped per image.
19	Input-source name — "Manual upload"	Sans 400 12px · #E6EDF3	Static.
20	Input-source abbreviation — DRONE	Mono 700 9px, .12em · #A8B6C2 · chip 1px solid #26333F on --panel #0C1219 · 8/11px pad	Shown to state that this channel exists and lands in the same pipeline. Not selectable in the prototype.
21	Input-source name — "Drone / aerial feed"	Sans 400 12px · #8B9AA8	Static.
22	Input-source abbreviation — SAT	Same as #20	Shown to state that this channel exists and lands in the same pipeline. Not selectable in the prototype.
23	Input-source name — "Satellite feed"	Same as #21	Static.
24	Input-source abbreviation — API	Same as #20	Shown to state that this channel exists and lands in the same pipeline. Not selectable in the prototype.
25	Input-source name — "Bulk / API submission"	Same as #21	Static.
26	Δ S3 change note	Mono 500 11px/1.5 · #9FE9E0 on accent @6% · 1px dashed #1D5B57 · "Δ S3" marker Mono 700 11px #2BD9C8	Prototype commentary, not product UI. Toggled by the header Δ ON/OFF control (showChangeNotes prop).
27	"IMAGE" label	Same as #3	Static.
28	Image drop zone — filled	679×127px · 1px dashed #2BD9C8 · --tint-2 #101B22 fill	Attached state: the dashed border and background switch to accent. Click replaces the file.
29	File-type glyph	37×29px · 1px solid #42525F	Decorative.
30	File name — "IMG_4475.jpg"	Sans 500 13.5px · #D5DFE8	Replaces the "Choose an image..." prompt.
31	File meta — "2.4 MB · JPEG · tap to replace"	Mono 400 11px · #8B9AA8	Size and type are fixed strings in the prototype.
32	"LATITUDE *" label	Mono 600 10px, .12–.16em, uppercase · #8B9AA8	Static.
33	Latitude input — filled	332×39px · Mono 400 14px #E6EDF3 · 1px solid #26333F (normal border retained)	Holds -37.6188. Valid values do not change the border colour; only the error state does.
34	"LONGITUDE *" label	Same as #32	Static.

#	Element	Visual spec	Behaviour / interaction
35	Longitude input — filled	As #33	Holds 145.3352.
36	"Use device location"	As state 1 #36	Overwrites both coordinate fields.
37	"CAPTURE TIME *" label	Same as #32	Static.
38	Capture-time input — filled	679×39px · as #33	Holds 2026-08-23 14:16.
39	"Use current time"	As state 1 #39	Overwrites the capture time.
40	"NOTES (OPTIONAL)" label	Same as #32	Static.
41	Notes input	As state 1 #41	Still empty; optional.
42	"Submit for assessment"	Mono 600 11px, .12em, uppercase · #04191A on #2BD9C8 · 1px solid #2BD9C8 · 12/22px pad	Now passes validation: one click moves the form to state 4.
43	"Clear"	As state 1 #43	Empties the form and detaches the file.
44	Status hint — "3 required fields"	Same as #31	Does NOT update when the fields are filled — it still reads "3 required fields". Flagged in section 4 as a copy defect.
45	Demo button — without geotag	As state 1 #45	Prototype control.
46	Demo button — fill valid submission	As state 1 #46	Prototype control.
47	Demo button — low-confidence result	As state 1 #47	Prototype control.
48	Demo button — not-a-fire result	As state 1 #48	Prototype control.

Figure 3 — State 3 — submission rejected (geotag missing)

Reached by pressing Submit with latitude or longitude empty, or via the "Demo: submit without geotag" control. The error banner is inserted at the top of the form card and both coordinate fields turn red. The attached image and the capture time are retained.

1 SUBMIT FIELD IMAGE

2 Every image runs the fire / not-fire check first, then severity scoring. Geotag and capture time are required.

3 SUBMISSION FLOW

4 **DONE** 5 6 **Attach image** 7 **2 WAITING** 8 9 **Geotag + capture time** 10 11 **3 WAITING** 12 **Submission confirmed** 13 14 **4 WAITING** 15 **AI assessment running**

16 **INPUT SOURCE** all four methods converge into this pipeline - source is recorded per image

17 **MANUAL** Manual upload **DRONE** Drone / aerial feed **SAT** Satellite feed **API** Bulk / API submission

18 19 20 Unchanged from WK2 apart from the input-source row: manual upload, drone, satellite and S3 bulk/API all converge into this one pipeline (FR11), so the source is recorded per image rather than built as four separate forms.

21 22 **27 SUBMISSION REJECTED - GEOTAG MISSING** 23 24 25 26 Latitude and longitude are required to place this incident on the map. Enter coordinates or use device location. 29

30 **IMAGE**

31 32 33 **IMG_4475.jpg** 34 3.4 MB · JPEG · tap to replace

35 **LATITUDE** 36 -37.6214 37 38 **LONGITUDE** 39 145.3087 40

41 Required - no geotag found in the image EXIF. Required - enter manually or use device location.

42 **USE DEVICE LOCATION**

43 **CAPTURE TIME** 44 2026-08-23 14:16

45 **USE CURRENT TIME**

46 **NOTES (OPTIONAL)** 47 Observed conditions, access, hazards

48 **SUBMIT FOR ASSESSMENT** 49 **CLEAR** 50 51 52 3 required fields

53 **DEMO: SUBMIT WITHOUT GEOTAG** **DEMO: FILL VALID SUBMISSION** **DEMO: LOW-CONFIDENCE RESULT**

54 **DEMO: NOT-A-FIRE RESULT**


#	Element	Visual spec	Behaviour / interaction
1	Screen title	Sans 600 22px/1.2, .08em, uppercase · #E6EDF3	Static.
2	Screen description	Sans 400 13.5px/1.5 · #8B9AA8	Static.
3	"SUBMISSION FLOW" heading	Mono 600 10px, .16em, uppercase · #8B9AA8	Static.
4	Step 1 marker — "✓"	21px circle · Mono 700 10px · #04190C on #35C46A, 1px solid #35C46A	Read-only progress marker driven by the form state.
5	Step 1 state word — "done"	Mono 600 10px, .12em, uppercase · #5FD98C	Derived from the form state; not clickable.
6	Step 1 label — "Attach image"	Sans 500 12.5px · #E6EDF3	Static label.
7	Step 2 marker — "2"	21px circle · Mono 700 10px · #8B9AA8, no fill, 1px solid #2C3A48	Read-only progress marker driven by the form state.
8	Step 2 state word — "waiting"	Mono 600 10px, .12em, uppercase · #8B9AA8	Derived from the form state; not clickable.
9	Step 2 label — "Geotag + capture time"	Sans 500 12.5px · #8B9AA8	Static label.

#	Element	Visual spec	Behaviour / interaction
10	Step 3 marker — "3"	Same as #7	Read-only progress marker driven by the form state.
11	Step 3 state word — "waiting"	Same as #8	Derived from the form state; not clickable.
12	Step 3 label — "Submission confirmed"	Same as #9	Static label.
13	Step 4 marker — "4"	Same as #7	Read-only progress marker driven by the form state.
14	Step 4 state word — "waiting"	Same as #8	Derived from the form state; not clickable.
15	Step 4 label — "AI assessment running"	Same as #9	Static label.
16	"INPUT SOURCE" label	Same as #3	Static.
17	Input-source note	Mono 400 10px · #8B9AA8	Static.
18	Input-source abbreviation — MANUAL	Mono 700 9px, .12em · #2BD9C8 · chip 1px solid #1D5B57 · 8/11px pad	Marks the channel this form represents. Static indicator, not a selector.
19	Input-source name — "Manual upload"	Sans 400 12px · #E6EDF3	Static.
20	Input-source abbreviation — DRONE	Mono 700 9px, .12em · #A8B6C2 · chip 1px solid #26333F · 8/11px pad	States that this channel exists and lands in the same pipeline. Not selectable.
21	Input-source name — "Drone / aerial feed"	Sans 400 12px · #8B9AA8	Static.
22	Input-source abbreviation — SAT	Same as #20	States that this channel exists and lands in the same pipeline. Not selectable.
23	Input-source name — "Satellite feed"	Same as #21	Static.
24	Input-source abbreviation — API	Same as #20	States that this channel exists and lands in the same pipeline. Not selectable.
25	Input-source name — "Bulk / API submission"	Same as #21	Static.
26	Δ S3 change note	Mono 500 11px/1.5 · #9FE9E0 on accent @6% · 1px dashed #1D5B57 · "Δ S3" marker Mono 700 11px #2BD9C8	Prototype commentary, not product UI. Toggled by the header Δ ON/OFF control (showChangeNotes prop).
27	Rejection icon — "!"	20×20px square · Mono 700 12px #FFFFFF on #E03127 · square corners	Static alert mark. The banner sits inside the form card, above the fields, on --err-bg #1A0C0B with a 1px #4A1E1A bottom border and 15/20px padding.
28	Rejection title — "Submission rejected — geotag missing"	Mono 600 11px/1.3, .12em, uppercase · #FF8C82	Title names the first failing field. Reads "Submission rejected — capture time missing" when the geotag is present but the time is not.
29	Rejection body	Sans 400 13.5px/1.45 · #C9A6A1	"Latitude and longitude are required to place this incident on the map. Enter coordinates or use device location." Explains the consequence, not just the rule.
30	"IMAGE" label	Same as #3	Static.
31	Image drop zone — filled	679×127px · 1px dashed #2BD9C8 · --tint-2 fill	The attached image is retained through a rejection; nothing is lost.
32	File-type glyph	37×29px · 1px solid #42525F	Decorative.
33	File name — "IMG_4475.jpg"	Sans 500 13.5px · #D5DFE8	Retained.
34	File meta	Mono 400 11px · #8B9AA8	Retained.

#	Element	Visual spec	Behaviour / interaction
35	"LATITUDE *" label	Mono 600 10px, .12–.16em, uppercase · #8B9AA8	Static.
36	Latitude input — error	332×39px · 1px solid #E03127 (hard stop red, not a token) · text #E6EDF3 on --input-bg	Border turns red on rejection. Typing any character clears the whole error state (submitState returns to idle and both borders reset).
37	Latitude error message	Mono 500 11px/1.4 · #FF8C82	"Required — no geotag found in the image EXIF." Names the cause, not just the omission.
38	"LONGITUDE *" label	Same as #35	Static.
39	Longitude input — error	As #36	Both coordinate fields are marked together; geotag is validated as one unit.
40	Longitude error message	Same as #37	"Required — enter manually or use device location." Points at the shortcut in #41.
41	"Use device location"	Mono 600 10px, .12em, uppercase · #2BD9C8	Fills both fields and clears the error.
42	"CAPTURE TIME *" label	Same as #35	Static.
43	Capture-time input	679×39px · 1px solid #26333F (normal)	Not in error here: it holds a value. Its own error message ("Required — without a capture time this image cannot be ordered against others.") appears in the same position when it is the failing field.
44	"Use current time"	Same as #41	Fills the capture time.
45	"NOTES (OPTIONAL)" label	Same as #35	Static.
46	Notes input	679×39px · 1px solid #26333F	Never validated.
47	"Submit for assessment"	Mono 600 11px, .12em, uppercase · #04191A on #2BD9C8 · 1px solid #2BD9C8 · 12/22px pad	Re-validates on every press. While either required field is empty the form stays on this screen and nothing is submitted — no record is created and the status flag is not set.
48	"Clear"	Same as #8	Empties the form and clears the rejection.
49	Status hint — "3 required fields"	Same as #34	Unchanged during a rejection.
50	Demo button — without geotag	Mono 600 10px · #8B9AA8 on --panel · 1px dashed #2C3A48	Prototype control: re-enters this state.
51	Demo button — fill valid submission	As #50	Prototype control.
52	Demo button — low-confidence result	Same as #51	Prototype control.
53	Demo button — not-a-fire result	Same as #51	Prototype control.

Figure 4 — State 4 — submission confirmed, assessment running

Reached by pressing Submit with all three required fields valid. This is the post-submission confirmation state: the submission is acknowledged with a reference while the AI assessment runs. It is transient — when the assessment completes the app leaves this screen (Map for a fire result, Archive for a not-a-fire result) and raises a toast naming the outcome.

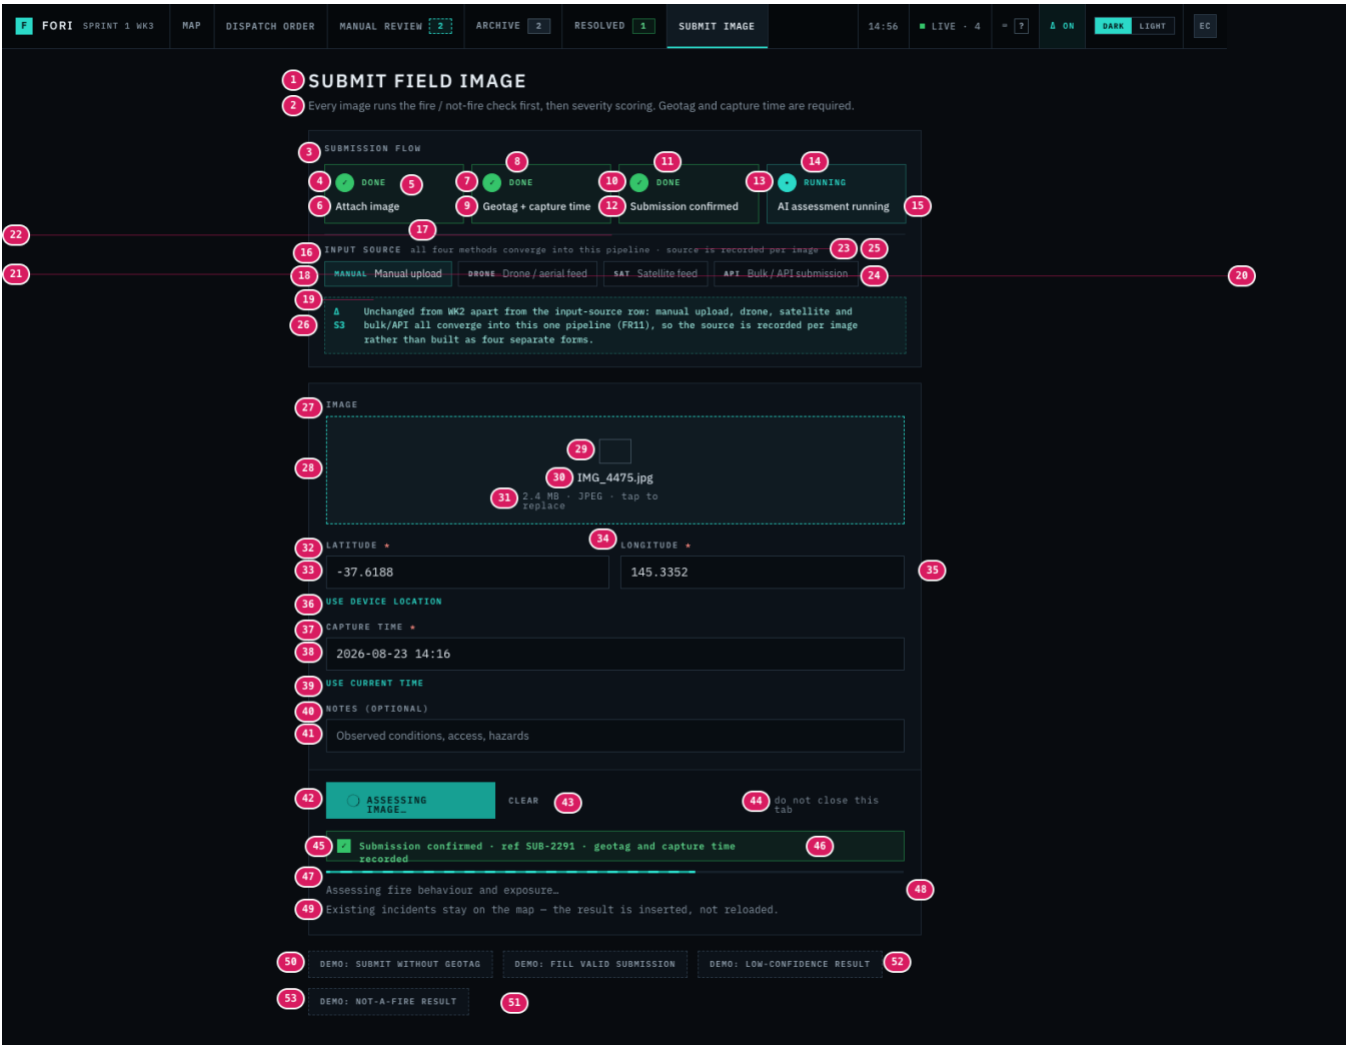

#	Element	Visual spec	Behaviour / interaction
1	Screen title	Sans 600 22px/1.2, .08em, uppercase · #E6EDF3	Static.
2	Screen description	Sans 400 13.5px/1.5 · #8B9AA8	Static.
3	"SUBMISSION FLOW" heading	Mono 600 10px, .16em, uppercase · #8B9AA8	Static.
4	Step 1 marker — "✓"	21px circle · Mono 700 10px · #04190C on #35C46A, 1px solid #35C46A	Read-only progress marker driven by the form state.
5	Step 1 state word — "done"	Mono 600 10px, .12em, uppercase · #5FD98C	Derived from the form state; not clickable.
6	Step 1 label — "Attach image"	Sans 500 12.5px · #E6EDF3	Static label.
7	Step 2 marker — "✓"	Same as #4	Read-only progress marker driven by the form state.
8	Step 2 state word — "done"	Same as #5	Derived from the form state; not clickable.
9	Step 2 label — "Geotag + capture time"	Same as #6	Static label.

#	Element	Visual spec	Behaviour / interaction
10	Step 3 marker — "✓"	Same as #4	Read-only progress marker driven by the form state.
11	Step 3 state word — "done"	Same as #5	Derived from the form state; not clickable.
12	Step 3 label — "Submission confirmed"	Same as #6	Static label.
13	Step 4 marker — "●"	21px circle · Mono 700 10px · #04191A on #2BD9C8, 1px solid #2BD9C8	Read-only progress marker driven by the form state.
14	Step 4 state word — "running"	Mono 600 10px, .12em, uppercase · #2BD9C8	Derived from the form state; not clickable.
15	Step 4 label — "AI assessment running"	Same as #6	Static label.
16	"INPUT SOURCE" label	Same as #3	Static.
17	Input-source note	Mono 400 10px · #8B9AA8	Static.
18	Input-source abbreviation — MANUAL	Mono 700 9px, .12em · #2BD9C8 · chip 1px solid #1D5B57 · 8/11px pad	Marks the channel this form represents. Static indicator, not a selector.
19	Input-source name — "Manual upload"	Sans 400 12px · #E6EDF3	Static.
20	Input-source abbreviation — DRONE	Mono 700 9px, .12em · #A8B6C2 · chip 1px solid #26333F · 8/11px pad	States that this channel exists and lands in the same pipeline. Not selectable.
21	Input-source name — "Drone / aerial feed"	Sans 400 12px · #8B9AA8	Static.
22	Input-source abbreviation — SAT	Same as #20	States that this channel exists and lands in the same pipeline. Not selectable.
23	Input-source name — "Satellite feed"	Same as #21	Static.
24	Input-source abbreviation — API	Same as #20	States that this channel exists and lands in the same pipeline. Not selectable.
25	Input-source name — "Bulk / API submission"	Same as #21	Static.
26	Δ S3 change note	Mono 500 11px/1.5 · #9FE9E0 on accent @6% · 1px dashed #1D5B57 · "Δ S3" marker Mono 700 11px #2BD9C8	Prototype commentary, not product UI. Toggled by the header Δ ON/OFF control (showChangeNotes prop).
27	"IMAGE" label	Same as #3	Static.
28	Image drop zone — filled	679×127px · 1px dashed #2BD9C8 · --tint-2 fill	Still clickable in the build, although the submission is already running. Flagged in section 4.
29	File-type glyph	37×29px · 1px solid #42525F	Decorative.
30	File name	Sans 500 13.5px · #D5DFE8	Retained through processing.
31	File meta	Mono 400 11px · #8B9AA8	Retained.
32	"LATITUDE *" label	Mono 600 10px, .12–.16em, uppercase · #8B9AA8	Static.
33	Latitude input	332×39px · 1px solid #26333F	Still editable during processing — the fields are not locked. Flagged in section 4.
34	"LONGITUDE *" label	Same as #32	Static.
35	Longitude input	As #33	Same.
36	"Use device location"	Mono 600 10px · #2BD9C8	Still active.
37	"CAPTURE TIME *" label	Same as #32	Static.


#	Element	Visual spec	Behaviour / interaction
38	Capture-time input	679×39px · 1px solid #26333F	Still editable.
39	"Use current time"	Same as #36	Still active.
40	"NOTES (OPTIONAL)" label	Same as #32	Static.
41	Notes input	Same as #38	Still editable.
42	Submit button — processing	198×41px · Mono 600 11px, .12em, uppercase · #04191A on --accent-deep #17A093 · 1px solid #17A093 · cursor default · 13px spinner, 2px ring in --on-accent-30 with an --on-accent top edge, spin .7s linear infinite · label "Assessing image..."	Disabled for the duration: further clicks are ignored while submitState is "processing". Returns to "Submit for assessment" on #2BD9C8 when the assessment completes and the screen changes.
43	"Clear"	Mono 600 10px · #8B9AA8	Still live during processing — pressing it empties the form while the assessment continues in the background. Flagged in section 4.
44	Status hint — "do not close this tab"	Mono 400 11px, .06em · #8B9AA8	Replaces "3 required fields" for the duration of the assessment.
45	Confirmation tick	16×16px square · Mono 700 10px #04190C on #35C46A	Marks the submission as accepted and recorded.
46	Confirmation line — "Submission confirmed · ref SUB-2291 · geotag and capture time recorded"	Mono 600 11px/1.4, .06em · #5FD98C · strip on green @9% with a 1px #1E6B3D border, 9/12px pad	This is the post-submission confirmation: it states the reference and that the mandatory metadata was captured. SUB-2291 is a fixed string in the prototype.
47	Assessment progress bar	679×4px track on --surface-3 #16202A · fill 64% wide, repeating-linear-gradient(90deg, --accent 0 12px, --accent-deep 12px 24px) · animation barSlide .8s linear infinite	Indeterminate: the 64% width never advances. It signals activity only, not completion.
48	Progress line 1 — "Assessing fire behaviour and exposure..."	Mono 400 12px/1.5 · #8B9AA8	States what the model is doing.
49	Progress line 2	Same as #48	"Existing incidents stay on the map — the result is inserted, not reloaded." Sets the expectation that the map will not reset.
50	Demo button — without geotag	Mono 600 10px · #8B9AA8 on --panel · 1px dashed #2C3A48	Prototype control.
51	Demo button — fill valid submission	As #50	Prototype control.
52	Demo button — low-confidence result	Same as #51	Prototype control.
53	Demo button — not-a-fire result	Same as #51	Prototype control.

Manual Review

Two columns: a 308px queue rail and the review pane. The rail header and the pane banner both carry a 135° diagonal hatch and a dashed accent border — the prototype signature for an outstanding human decision. Five distinct states are documented: a flagged image loaded, the screen immediately after each of Confirm, Change and Discard, and the empty queue.

Figure 5 — State 1 — flagged image loaded (default entry state)

Entered from the MANUAL REVIEW tab, the map flagged strip, the Alerts panel, or a Review button in the dispatch order. Selected image INC-0433 at confidence 0.34. Badges 1–17 cover the queue rail; 18–112 the review pane.

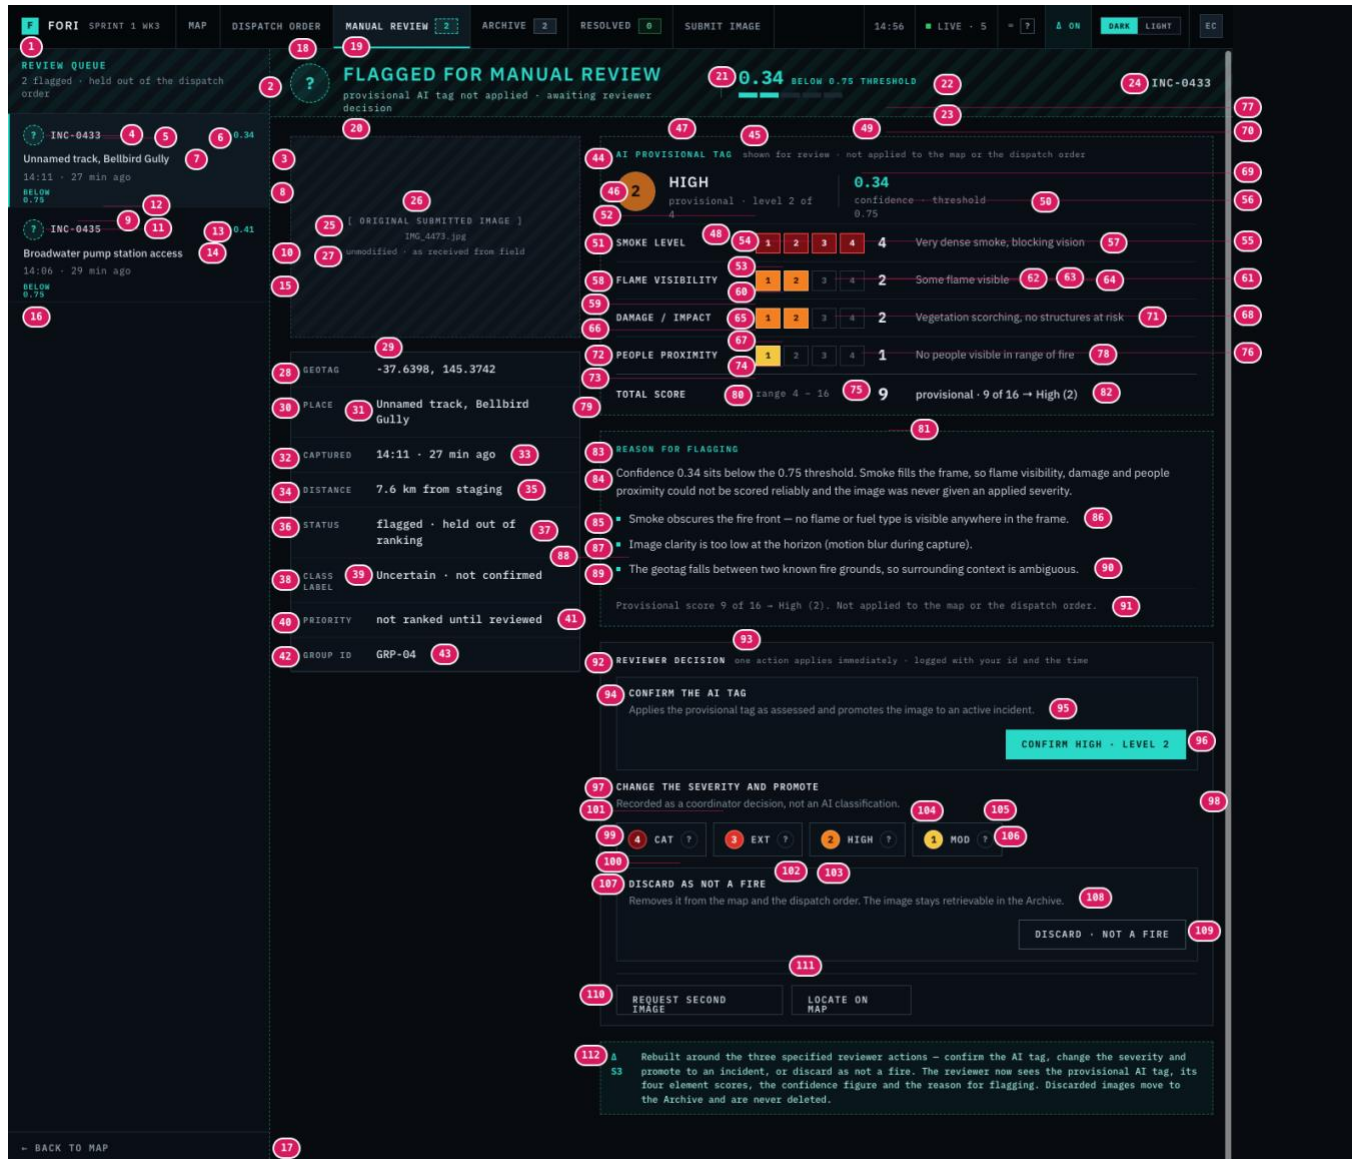

#	Element	Visual spec	Behaviour / interaction
1	Review Queue rail heading	Mono 600 11px, .16em, uppercase · #2BD9C8 · 14/16px pad · 135° hatch (accent @7% over accent @2%, 10px stripes) · 1px #1F2A35 bottom border	Static. The 308px rail carries a 1px dashed #1D5B57 right border — the prototype signal for an outstanding human decision.
2	Queue count line	Mono 400 11px/1.4 · #8B9AA8	Live count of images below the threshold: 2 flagged · held out of the dispatch order.
3	Queue row — INC-0433 (selected)	307×110px · bg --tint #101A22 · 3px solid #2BD9C8 left mark · 1px #161F28 bottom divider · hover bg --surface-2	Click loads that image into the review pane. No navigation and no change to the image state.

#	Element	Visual spec	Behaviour / interaction
4	Queue flag badge	25px circle · accent @10% fill · 2px dashed #2BD9C8 · Mono 700 11px #2BD9C8 question mark	Marks the item as undecided. Never shows a severity numeral.
5	Queue image ID — INC-0433	Mono 600 11px · #C4D0DA	Static.
6	Queue confidence — 0.34	Mono 600 10px · #2BD9C8 · right-aligned	The confidence that routed it here; always below 0.75 in this queue.
7	Queue place — Unnamed track, Bellbird Gully	Sans 500 12.5px · #D5DFE8	Static.
8	Queue capture line — 14:11 · 27 min ago	Mono 400 11px · #8B9AA8	Relative age advances with the clock.
9	Queue reason — below 0.75	Mono 600 9px, uppercase · #2BD9C8	Why it is in the queue. Other values: sent by coordinator; restored · was not a fire; restored · was discarded.
10	Queue row — INC-0435	307×110px · transparent, no left mark · 1px #161F28 bottom divider · hover bg --surface-2	Click loads that image into the review pane. No navigation and no change to the image state.
11	Queue flag badge	Same as #4	Marks the item as undecided. Never shows a severity numeral.
12	Queue image ID — INC-0435	Same as #5	Static.
13	Queue confidence — 0.41	Same as #6	The confidence that routed it here; always below 0.75 in this queue.
14	Queue place — Broadwater pump station access	Same as #7	Static.
15	Queue capture line — 14:06 · 29 min ago	Same as #8	Relative age advances with the clock.
16	Queue reason — below 0.75	Same as #9	Why it is in the queue. Other values: sent by coordinator; restored · was not a fire; restored · was discarded.
17	← Back to map rail footer	Mono 600 11px, .12em, uppercase · #8B9AA8 · 13/16px pad · 1px #1F2A35 top border · hover text --fg	Click → Map.
18	Flag badge (pane)	47px circle · accent @10% fill · 2px dashed #2BD9C8 · Mono 700 20px question mark	State marker; present only while the image is undecided.
19	Banner headline — Flagged for manual review	Sans 600 22px, .08em, uppercase · #2BD9C8	One of three headlines: Flagged for manual review (below threshold), Sent for a human check (coordinator withdrew the tag), Restored for re-check (returned from the Archive).
20	Banner subline	Mono 400 11px/1.4 · #9FE9E0	provisional AI tag not applied · awaiting reviewer decision.
21	Banner confidence — 0.34	Mono 700 22px · #2BD9C8	The model confidence, restated at banner scale.
22	Threshold label — Below 0.75 threshold	Mono 600 10px, .14em, uppercase · #2BD9C8	Fixed threshold, exposed as the confidenceThreshold prop (default 75%).
23	Confidence segments	Five 22×6px segments · filled #2BD9C8, empty #1B2731 · 20px left pad behind a 1px #1D5B57 rule	Segment count = round(confidence / 20), minimum 1.
24	Image ID — INC-0433	Mono 600 13px, .08em · #C4D0DA · right-aligned	Static.
25	Image placeholder frame	340×236px · 1px dashed #2C3A48 · 135° hatch #0E141B / #111921 at 8px · caption Mono 500 10px #8B9AA8	Placeholder for the submitted image.
26	Image file name — IMG_4473.jpg	Mono 400 10px · #8B9AA8	From the submission record.

#	Element	Visual spec	Behaviour / interaction
27	Image caption — unmodified · as received from field	Same as #26	States that the reviewed frame has had no processing applied.
28	Field key — GEOTAG	Mono 600 10px, .12em, uppercase · #8B9AA8	Metadata card: 1px #22303C on --panel, rows 11/14px pad, 1px #161F28 dividers, 74px key column.
29	Field value — -37.6398, 145.3742	Mono 500 13px · #E6EDF3	Read-only.
30	Field key — PLACE	Same as #28	Metadata card: 1px #22303C on --panel, rows 11/14px pad, 1px #161F28 dividers, 74px key column.
31	Field value — Unnamed track, Bellbird Gully	Same as #29	Read-only.
32	Field key — CAPTURED	Same as #28	Metadata card: 1px #22303C on --panel, rows 11/14px pad, 1px #161F28 dividers, 74px key column.
33	Field value — 14:11 · 27 min ago	Same as #29	Read-only.
34	Field key — DISTANCE	Same as #28	Metadata card: 1px #22303C on --panel, rows 11/14px pad, 1px #161F28 dividers, 74px key column.
35	Field value — 7.6 km from staging	Same as #29	Read-only.
36	Field key — STATUS	Same as #28	Metadata card: 1px #22303C on --panel, rows 11/14px pad, 1px #161F28 dividers, 74px key column.
37	Field value — flagged · held out of ranking	Same as #29	Reflects the status flag Flagged for Manual Review: the image is held out of the map and the ranking.
38	Field key — CLASS LABEL	Same as #28	Metadata card: 1px #22303C on --panel, rows 11/14px pad, 1px #161F28 dividers, 74px key column.
39	Field value — Uncertain · not confirmed	Same as #29	Classification label while unresolved; resolves to Fire / Non-Fire / Extinguished after a decision.
40	Field key — PRIORITY	Same as #28	Metadata card: 1px #22303C on --panel, rows 11/14px pad, 1px #161F28 dividers, 74px key column.
41	Field value — not ranked until reviewed	Same as #29	Flagged images are never given a queue position.
42	Field key — GROUP ID	Same as #28	Metadata card: 1px #22303C on --panel, rows 11/14px pad, 1px #161F28 dividers, 74px key column.
43	Field value — GRP-04	Same as #29	Reads none when the image is not in a proposed group.
44	AI PROVISIONAL TAG heading	Mono 600 10px, .16em, uppercase · #2BD9C8 · card 1px dashed #1D5B57 on --surface · 16/18px pad	Names the withheld tag so it cannot be mistaken for an applied severity.
45	Provisional-tag note	Same as #26	shown for review · not applied to the map or the dispatch order.
46	Provisional severity numeral — 2	Mono 700 18px · inside a 47px dot: #F58021 fill · #1A0C02 numeral · 2px #FFB36B ring · 2px DASHED ring · opacity .75	The dashed ring and 75% opacity are the only cues separating a provisional dot from an applied one.
47	Provisional band name — High	Sans 600 17px, uppercase · #E6EDF3	Derived from the element sum; not stored.
48	Provisional level line — provisional · level 2 of 4	Same as #8	States the band position without applying it.
49	Provisional confidence — 0.34	Mono 700 17px · #2BD9C8 · behind a 1px #26333F rule	Second instance of the confidence figure, beside the tag it qualifies.

#	Element	Visual spec	Behaviour / interaction
50	Confidence caption — confidence · threshold 0.75	Same as #8	Names the comparison being made.
51	Element label — Smoke level	Mono 600 11px, .08em, uppercase · #D5DFE8 · 150px column · 1px #161F28 top border	Read-only. One of four elements scored 1–4 and summed to the 4–16 total.
52	Score cell 1 (filled)	28×23px · Mono 700 10px · #7A0F16 fill · #FFFFFF numeral · 4px #FF4D4D ring · 1px ring	Filled up to the element score. Display only.
53	Score cell 2 (filled)	Same as #52	Filled up to the element score. Display only.
54	Score cell 3 (filled)	Same as #52	Filled up to the element score. Display only.
55	Score cell 4 (filled)	Same as #52	Filled up to the element score. Display only.
56	Element value — 4	Mono 700 16px · #E6EDF3	The 1–4 score for this element.
57	Element description	Sans 400 13px · #A8B6C2	Fixed rubric string: Very dense smoke, blocking vision
58	Element label — Flame visibility	Same as #51	Read-only. One of four elements scored 1–4 and summed to the 4–16 total.
59	Score cell 1 (filled)	28×23px · Mono 700 10px · #F58021 fill · #1A0C02 numeral · 2px #FFB36B ring · 1px ring	Filled up to the element score. Display only.
60	Score cell 2 (filled)	Same as #59	Filled up to the element score. Display only.
61	Score cell 3 (empty)	28×23px · Mono 700 10px · #5C6B77 text · no fill · 1px solid #26333F	Unfilled cell above the score. Display only.
62	Score cell 4 (empty)	Same as #61	Unfilled cell above the score. Display only.
63	Element value — 2	Same as #56	The 1–4 score for this element.
64	Element description	Same as #57	Fixed rubric string: Some flame visible
65	Element label — Damage / impact	Same as #51	Read-only. One of four elements scored 1–4 and summed to the 4–16 total.
66	Score cell 1 (filled)	Same as #59	Filled up to the element score. Display only.
67	Score cell 2 (filled)	Same as #59	Filled up to the element score. Display only.
68	Score cell 3 (empty)	Same as #61	Unfilled cell above the score. Display only.
69	Score cell 4 (empty)	Same as #61	Unfilled cell above the score. Display only.
70	Element value — 2	Same as #56	The 1–4 score for this element.
71	Element description	Same as #57	Fixed rubric string: Vegetation scorching, no structures at risk
72	Element label — People proximity	Same as #51	Read-only. One of four elements scored 1–4 and summed to the 4–16 total.
73	Score cell 1 (filled)	28×23px · Mono 700 10px · #F5C842 fill · #1A1405 numeral · 2px #FFE08A ring · 1px ring	Filled up to the element score. Display only.
74	Score cell 2 (empty)	Same as #61	Unfilled cell above the score. Display only.
75	Score cell 3 (empty)	Same as #61	Unfilled cell above the score. Display only.
76	Score cell 4 (empty)	Same as #61	Unfilled cell above the score. Display only.
77	Element value — 1	Same as #56	The 1–4 score for this element.
78	Element description	Same as #57	Fixed rubric string: No people visible in range of fire
79	Total score label	Mono 600 11px, .08em, uppercase · #E6EDF3 · 1px #2C3A48 top border, 13px top pad	—
80	Range note — range 4 – 16	Same as #8	States the fixed scale.


#	Element	Visual spec	Behaviour / interaction
81	Total value — 9	Mono 700 20px · #E6EDF3	Sum of the four element scores.
82	Band sentence	Sans 500 13.5px · #D5DFE8	provisional · 9 of 16 → High (2). States the mapping being proposed, not applied.
83	REASON FOR FLAGGING heading	Mono 600 10px, .16em, uppercase · #2BD9C8 · card 1px dashed #1D5B57 on --surface	Section label.
84	Flagging reason prose	Sans 400 13.5px/1.55 · #D5DFE8 · text-wrap: pretty	Confidence 0.34 sits below the 0.75 threshold. Smoke fills the frame, so flame visibility, damage and people proximity could not be scored reliably and the image was never given an applied severity.
85	Reason bullet marker	5×5px solid #2BD9C8 square	Marker for the bullet beside it.
86	Reason bullet	Sans 400 13.5px/1.55 · #D5DFE8	Smoke obscures the fire front — no flame or fuel type is visible anywhere in the frame.
87	Reason bullet marker	Same as #85	Marker for the bullet beside it.
88	Reason bullet	Same as #86	Image clarity is too low at the horizon (motion blur during capture).
89	Reason bullet marker	Same as #85	Marker for the bullet beside it.
90	Reason bullet	Same as #86	The geotag falls between two known fire grounds, so surrounding context is ambiguous.
91	Withheld-score note	Mono 400 11px/1.5 · #8B9AA8 · 1px --tint top border, 11px top pad	Provisional score 9 of 16 → High (2). Not applied to the map or the dispatch order.
92	REVIEWER DECISION heading	Mono 600 10px, .16em, uppercase · #E6EDF3 · card 1px solid #26333F on --map-bg #0A1016	Separates the decision area from the evidence above it.
93	Decision note	Same as #26	one action applies immediately · logged with your id and the time — states that there is no confirmation step.
94	Confirm block label — Confirm the AI tag	Mono 600 11px, .1em, uppercase · #E6EDF3 · inner panel 1px #22303C on --panel · 13/14px pad	Static.
95	Confirm block description	Sans 400 12.5px · #8B9AA8	Applies the provisional tag as assessed and promotes the image to an active incident.
96	CONFIRM button — reviewer action 1 — Confirm HIGH · level 2	Mono 600 11px, .12em, uppercase · #04191A on #2BD9C8 · 1px solid #2BD9C8 · 11/18px pad · hover #7FEFE3 · active #17A093 · label is dynamic (band + level) · focus 2px #7FEFE3 outline at 3px offset	REVIEWER ACTION 1. Applies the provisional band as final and promotes the image to an active incident. Status flag → Processed. Writes AI provisional tag confirmed: High (2), scored 9 of 16 to the decision log with the coordinator id and the time. The screen then LEAVES Manual Review for Incident Detail and raises the AI tag confirmed toast.
97	Change block label — Change the severity and promote	Mono 600 11px, .1em, uppercase · #E6EDF3	Static.
98	Change block description	Same as #95	Recorded as a coordinator decision, not an AI classification.
99	Severity chip CAT — reviewer action 2	Chip --panel · 1px solid #2C3A48 · 7/13px pad · 20px dot (#7A0F16 fill · #FFFFFF numeral · 4px #FF4D4D ring, 2px ring) · label Mono 600 11px, .1em, uppercase #C4D0DA · selected: bg accent @12%, 1px #2BD9C8, label #7FEFE3	REVIEWER ACTION 2 (one of four chips). One click sets severity 4 and promotes the image. The four element scores are cleared to not scored, the record is marked coordinator-assigned, the log records Severity assigned manually, the flag becomes Processed, and the screen moves to Incident Detail with a toast. Chips run 4 → 1, so Change is four buttons rather than one (see Open items).
100	Band explainer ? — CAT	19px circle · Mono 700 10px · #8B9AA8 · 1px solid	Toggles an inline rubric panel giving the band name,

#	Element	Visual spec	Behaviour / interaction
		#26333F · hover border and text #2BD9C8, bg accent @10%	level n of 4 and its plain-language definition. One open at a time; does not change the severity.
101	Severity chip EXT — reviewer action 2	Chip --panel · 1px solid #2C3A48 · 7/13px pad · 20px dot (#E03127 fill · #FFFFFF numeral · 3px #FF8078 ring, 2px ring) · label Mono 600 11px, .1em, uppercase #C4D0DA · selected: bg accent @12%, 1px #2BD9C8, label #7FEFE3	REVIEWER ACTION 2 (one of four chips). One click sets severity 3 and promotes the image. The four element scores are cleared to not scored, the record is marked coordinator-assigned, the log records Severity assigned manually, the flag becomes Processed, and the screen moves to Incident Detail with a toast. Chips run 4 → 1, so Change is four buttons rather than one (see Open items).
102	Band explainer ? — EXT	Same as #100	Toggles an inline rubric panel giving the band name, level n of 4 and its plain-language definition. One open at a time; does not change the severity.
103	Severity chip HIGH — reviewer action 2	Chip --panel · 1px solid #2C3A48 · 7/13px pad · 20px dot (#F58021 fill · #1A0C02 numeral · 2px #FFB36B ring, 2px ring) · label Mono 600 11px, .1em, uppercase #C4D0DA · selected: bg accent @12%, 1px #2BD9C8, label #7FEFE3	REVIEWER ACTION 2 (one of four chips). One click sets severity 2 and promotes the image. The four element scores are cleared to not scored, the record is marked coordinator-assigned, the log records Severity assigned manually, the flag becomes Processed, and the screen moves to Incident Detail with a toast. Chips run 4 → 1, so Change is four buttons rather than one (see Open items).
104	Band explainer ? — HIGH	Same as #100	Toggles an inline rubric panel giving the band name, level n of 4 and its plain-language definition. One open at a time; does not change the severity.
105	Severity chip MOD — reviewer action 2	Chip --panel · 1px solid #2C3A48 · 7/13px pad · 20px dot (#F5C842 fill · #1A1405 numeral · 2px #FFE08A ring, 2px ring) · label Mono 600 11px, .1em, uppercase #C4D0DA · selected: bg accent @12%, 1px #2BD9C8, label #7FEFE3	REVIEWER ACTION 2 (one of four chips). One click sets severity 1 and promotes the image. The four element scores are cleared to not scored, the record is marked coordinator-assigned, the log records Severity assigned manually, the flag becomes Processed, and the screen moves to Incident Detail with a toast. Chips run 4 → 1, so Change is four buttons rather than one (see Open items).
106	Band explainer ? — MOD	Same as #100	Toggles an inline rubric panel giving the band name, level n of 4 and its plain-language definition. One open at a time; does not change the severity.
107	Discard block label — Discard as not a fire	Same as #97	Static.
108	Discard block description	Same as #95	Removes it from the map and the dispatch order. The image stays retrievable in the Archive.
109	DISCARD button — reviewer action 3	Mono 600 11px, .12em, uppercase · #C4D0DA · transparent · 1px solid #42525F · 11/18px pad · hover bg --surface-2	REVIEWER ACTION 3. Marks the image Not a Fire, removes it from the map and the dispatch order, records the dismissal (reason, who, time) and moves the record to the Archive. Unlike Confirm and Change it STAYS on Manual Review and loads the next queue item.
110	Request second image button	Mono 600 11px, .12em, uppercase · #C4D0DA · 1px solid #2C3A48 · 11/18px pad · hover bg --surface-2	Raises a Second image requested toast. The image keeps its flagged status and stays in the queue. Not one of the three specified reviewer actions (see Open items).
111	Locate on map button	Same as #110	Switches to the Map at zoom 3 and pulses the marker — but a flagged image has no marker until it is confirmed, so there is nothing to pulse (see Open items).
112	Δ S3 change note	Mono 500 11px/1.5 · #9FE9E0 on accent @6% · 1px	Prototype commentary, not product UI. Toggled by

#	Element	Visual spec	Behaviour / interaction
		dashed #1D5B57 · Δ S3 marker Mono 700 11px #2BD9C8	the header Δ ON/OFF control.

Figure 6 — State 2 — immediately after Confirm

Confirm does not stay on Manual Review: the screen is replaced by Incident Detail for the newly promoted incident, with the toast at top right (shown here at the foot of the figure so it does not cover the screen). Badges 122–128 cover the toast.

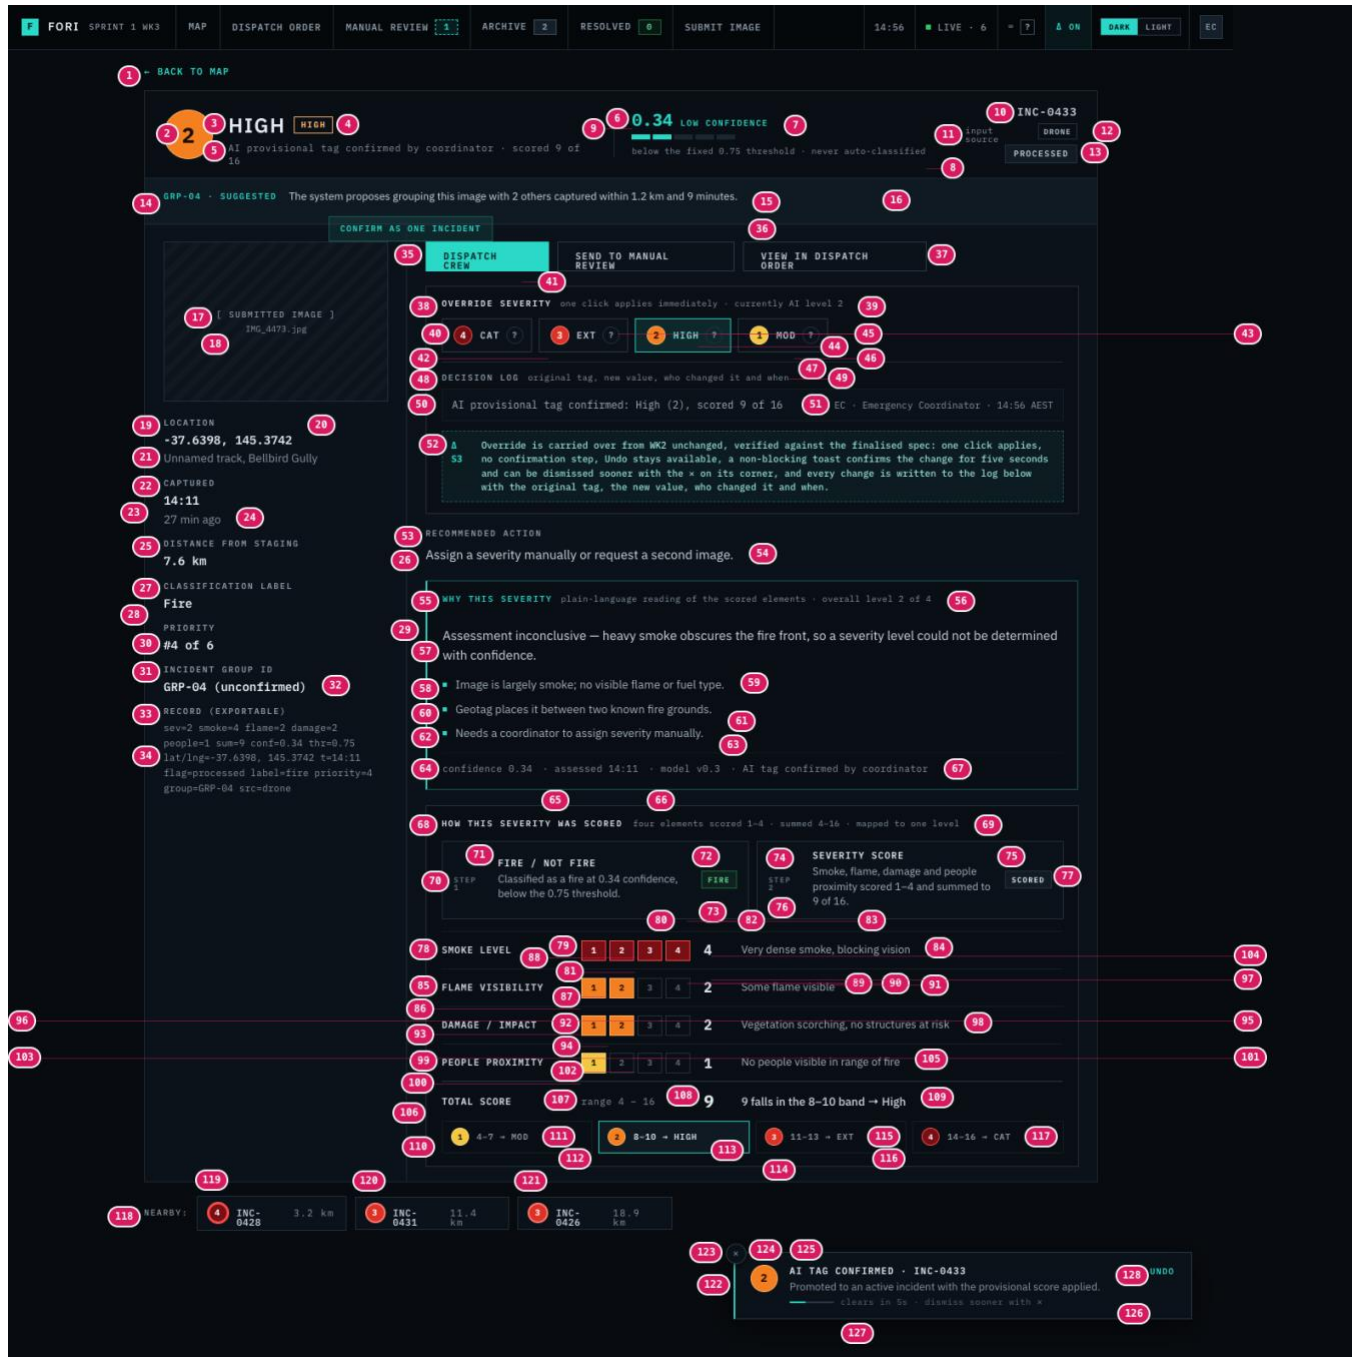

#	Element	Visual spec	Behaviour / interaction
1	← Back to map link	Mono 600 11px, .1em, uppercase · #2BD9C8 · hover #7FEFE3	Click → Map, whatever screen the user arrived from.
2	Severity numeral — 2	Mono 700 25px · #1A0C02 · inside a 64px dot (56px + 4px #FFB36B ring) with a 4px --halo outer ring	The band level 1–4, or a question mark when no severity is applied. Diameter and ring weight step with the band (26/2, 34/2, 42/3, 50/4 base).
3	Band name — High	Sans 600 24px/1.1, .06em, uppercase · #E6EDF3	Derived from the applied severity.
4	Band abbreviation chip	Mono 700 10px, .14em · #FFB36B on --halo #0A1016 ·	Static.

#	Element	Visual spec	Behaviour / interaction
		1px solid #FFB36B · 4/7px pad	
5	Provenance line	Mono 400 11px/1.4 · #8B9AA8	AI provisional tag confirmed by coordinator · scored 9 of 16 — the dashed provisional treatment is gone; this is now an applied severity.
6	Confidence figure — 0.34	Mono 700 20px · #2BD9C8	The model confidence for this image. A coordinator action never changes it.
7	Confidence label — Low confidence	Mono 600 10px, .14em, uppercase · #2BD9C8	≥0.85 High confidence #35C46A · 0.75–0.84 Moderate #F5C842 · below 0.75 Low #2BD9C8.
8	Confidence segments	Five 22×6px segments · filled #2BD9C8, empty #1B2731 · 20px left pad behind a 1px --border rule	Segment count = round(confidence / 20), minimum 1.
9	Threshold note	Mono 400 10px/1.4 · #8B9AA8	below the fixed 0.75 threshold · never auto-classified
10	Incident ID — INC-0433	Mono 600 13px, .08em · #C4D0DA · right-aligned	Static.
11	input source label	Mono 400 10px · #8B9AA8	Labels the channel chip.
12	Input-source chip — DRONE	Mono 700 9px, .12em · #A8B6C2 · 1px solid #26333F · 4/6px pad · tooltip gives the full channel name	The visible per-incident record of which of the four input channels the image arrived on: MANUAL / DRONE / SAT / API.
13	Status flag chip — Processed	Mono 600 10px, .12em, uppercase · #C4D0DA on --surface-2 #131C25 · 1px solid #26333F · 5/9px pad	One flag per image at a time: Processed / Flagged · review / Not a fire / Extinguished / Dispatched.
14	Grouping banner title — GRP-04 · SUGGESTED	Mono 600 10px, .14em · #2BD9C8 · full-width band on --tint with a 1px --border bottom	Shown only for images in the proposed group. The suffix follows the group state: SUGGESTED, GROUPED, KEPT SEPARATE.
15	Grouping banner sentence	Sans 400 12.5px · #D5DFE8	States the proximity and time window behind the proposal.
16	Grouping banner action — Confirm as one incident	Mono 600 10px, .12em, uppercase · #2BD9C8 on accent @10% · 1px solid #1D5B57 · 9/12px pad	One click confirms the group and logs it; the action then becomes Split into separate incidents. Nothing is auto-committed.
17	Image placeholder frame	308px column · 186px tall · 1px #22303C · 135° hatch #0E141B / #111921 at 8px	Placeholder for the incident image.
18	Image file name	Same as #11	From the submission record.
19	Field key — LOCATION	Mono 600 10px, .16em, uppercase · #8B9AA8	Read-only field label.
20	Field value — -37.6398, 145.3742	Mono 600 14px/1.3 · #E6EDF3	Read-only.
21	Field sub-line — Unnamed track, Bellbird Gully	Sans 400 13.5px · #8B9AA8	Secondary line under the value.
22	Field key — CAPTURED	Same as #19	Read-only field label.
23	Field value — 14:11	Same as #20	Read-only.
24	Field sub-line — 27 min ago	Same as #21	Secondary line under the value.
25	Field key — DISTANCE FROM STAGING	Same as #19	Read-only field label.
26	Field value — 7.6 km	Same as #20	Read-only.
27	Field key — CLASSIFICATION LABEL	Same as #19	Read-only field label.
28	Field value — Fire	Same as #20	Resolves to Fire / Non-Fire / Extinguished / Uncertain.
29	Field key — PRIORITY	Same as #19	Read-only field label.
30	Field value — #4 of 6	Same as #20	Resolves to #n of m, live · crew dispatched, not

#	Element	Visual spec	Behaviour / interaction
			ranked, or resolved · not ranked.
31	Field key — INCIDENT GROUP ID	Same as #19	Read-only field label.
32	Field value — GRP-04 (unconfirmed)	Same as #20	Resolves to GRP-04, GRP-04 (unconfirmed), or none.
33	RECORD (EXPORTABLE) key	Same as #19	Labels the flat record dump.
34	Exportable record	Mono 400 11px/1.6 · #8B9AA8	sev=2 smoke=4 flame=2 damage=2 people=1 sum=9 conf=0.34 thr=0.75 lat/lng=-37.6398, 145.3742 t=14:11 flag=processed label=fire priority=4 group=GRP-04 src=drone — Confirm writes the applied severity while keeping the original confidence and all four element scores.
35	Dispatch crew primary button	Mono 600 11px, .12em, uppercase · #04191A on #2BD9C8 · 1px solid #2BD9C8 · 11/20px pad · hover #7FEFE3 · active #17A093	Assigns a crew: the incident moves to LIVE / DISPATCHED in the dispatch order, the flag becomes Dispatched, the button relabels to Crew dispatched ✓, and Mark extinguished and Cancel dispatch appear. Toast: Tanker 12 en route.
36	Send to manual review button	Mono 600 11px, .12em, uppercase · #C4D0DA · 1px solid #2C3A48 · 11/20px pad · hover bg --surface-2	Withdraws the applied tag, removes the incident from the ranking and the map, adds it to the review queue marked sent by coordinator, logs it and navigates to Manual Review.
37	View in dispatch order button	Same as #36	Click → Dispatch Order.
38	OVERRIDE SEVERITY heading	Mono 600 10px, .16em, uppercase · #E6EDF3 · card 1px solid #26333F on --map-bg · 15/18px pad	Section label.
39	Override state note	Same as #11	one click applies immediately · currently AI level 2
40	Override chip CAT	Chip --panel · 1px solid #2C3A48 · 20px dot (#7A0F16 fill · #FFFFFF numeral · 4px #FF4D4D ring, 2px ring) · label Mono 600 11px, .1em, uppercase #C4D0DA · current level: bg accent @12%, 1px #2BD9C8, label #7FEFE3	One click applies severity 4 immediately — no confirmation dialog and no save step. The ranking, the map marker and the dispatch order recalculate, an Undo appears, and the change is written to the decision log with the original value, the new value, who and when.
41	Band explainer ? — CAT	19px circle · Mono 700 10px · #8B9AA8 · 1px solid #26333F · hover border and text #2BD9C8, bg accent @10%	Toggles the inline rubric panel for that band. Does not change the severity.
42	Override chip EXT	Chip --panel · 1px solid #2C3A48 · 20px dot (#E03127 fill · #FFFFFF numeral · 3px #FF8078 ring, 2px ring) · label Mono 600 11px, .1em, uppercase #C4D0DA · current level: bg accent @12%, 1px #2BD9C8, label #7FEFE3	One click applies severity 3 immediately — no confirmation dialog and no save step. The ranking, the map marker and the dispatch order recalculate, an Undo appears, and the change is written to the decision log with the original value, the new value, who and when.
43	Band explainer ? — EXT	Same as #41	Toggles the inline rubric panel for that band. Does not change the severity.
44	Override chip HIGH	Chip --panel · 1px solid #2C3A48 · 20px dot (#F58021 fill · #1A0C02 numeral · 2px #FFB36B ring, 2px ring) · label Mono 600 11px, .1em, uppercase #C4D0DA · current level: bg accent @12%, 1px #2BD9C8, label #7FEFE3	One click applies severity 2 immediately — no confirmation dialog and no save step. The ranking, the map marker and the dispatch order recalculate, an Undo appears, and the change is written to the decision log with the original value, the new value, who and when.
45	Band explainer ? — HIGH	Same as #41	Toggles the inline rubric panel for that band. Does not change the severity.
46	Override chip MOD	Chip --panel · 1px solid #2C3A48 · 20px dot (#F5C842	One click applies severity 1 immediately — no

#	Element	Visual spec	Behaviour / interaction
		fill · #1A1405 numeral · 2px #FFE08A ring, 2px ring) · label Mono 600 11px, .1em, uppercase #C4D0DA · current level: bg accent @12%, 1px #2BD9C8, label #7FEFE3	confirmation dialog and no save step. The ranking, the map marker and the dispatch order recalculate, an Undo appears, and the change is written to the decision log with the original value, the new value, who and when.
47	Band explainer ? — MOD	Same as #41	Toggles the inline rubric panel for that band. Does not change the severity.
48	DECISION LOG heading	Mono 600 10px, .16em, uppercase · #8B9AA8 · 1px --border top rule, 13px top pad	Per-incident log only. There is no cross-incident audit view in the build.
49	Decision-log note	Same as #11	original tag, new value, who changed it and when — states the shape of each entry.
50	Log entry — confirmation	Mono 400 12px/1.5 · #A8B6C2 · row 1px #161F28 on -panel · 9/11px pad	AI provisional tag confirmed: High (2), scored 9 of 16 — written the moment Confirm was pressed.
51	Log entry who / when	Mono 400 11px · #8B9AA8 · right-aligned	EC · Emergency Coordinator · 14:56 AEST
52	Δ S3 change note	Mono 500 11px/1.5 · #9FE9E0 on accent @6% · 1px dashed #1D5B57 · Δ S3 marker Mono 700 11px #2BD9C8	Prototype commentary, not product UI. Toggled by the header Δ ON/OFF control.
53	RECOMMENDED ACTION heading	Same as #19	Section label.
54	Recommended action text	Sans 400 15px/1.5 · #D5DFE8	Assign a severity manually or request a second image.
55	WHY THIS SEVERITY heading	Mono 600 10px, .16em, uppercase · #2BD9C8 · panel 1px solid #1D5B57 with a 3px solid #2BD9C8 left border on --surface · 16/18px pad	Read-only explanation panel.
56	Why-this-severity note	Same as #11	plain-language reading of the scored elements · overall level n of 4.
57	Severity summary	Sans 400 15px/1.55 · #D5DFE8	Assessment inconclusive — heavy smoke obscures the fire front, so a severity level could not be determined with confidence.
58	Reason bullet marker	5×5px solid #2BD9C8 square	Marker for the bullet beside it.
59	Reason bullet	Sans 400 13.5px/1.55 · #A8B6C2	Image is largely smoke; no visible flame or fuel type.
60	Reason bullet marker	Same as #58	Marker for the bullet beside it.
61	Reason bullet	Same as #59	Geotag places it between two known fire grounds.
62	Reason bullet marker	Same as #58	Marker for the bullet beside it.
63	Reason bullet	Same as #59	Needs a coordinator to assign severity manually.
64	Footer — confidence	Mono 400 11px · #8B9AA8	Restates the confidence figure.
65	Footer — assessed time	Same as #64	When the assessment ran.
66	Footer — model version	Same as #64	model v0.3 — a fixed string in the prototype.
67	Footer — provenance	Same as #64	· AI tag confirmed by coordinator — the last token states provenance: AI-classified, AI tag confirmed by coordinator, coordinator override, or coordinator-assigned.
68	HOW THIS SEVERITY WAS SCORED heading	Mono 600 10px, .16em, uppercase · #E6EDF3 · card 1px solid #26333F on --surface	Section label.
69	Scoring note	Same as #11	four elements scored 1–4 · summed 4–16 · mapped to one level.
70	STEP 1 marker	Mono 700 9px, .14em · #5C6B77 · tile 1px #22303C on	States the pipeline order: the fire / not-fire gate runs


#	Element	Visual spec	Behaviour / interaction
		--panel · 11/13px pad	before any scoring.
71	STEP 1 title — Fire / not fire	Mono 600 11px, .1em, uppercase · #E6EDF3	Static.
72	STEP 1 body	Sans 400 12.5px · #A8B6C2	Classified as a fire at 0.34 confidence, below the 0.75 threshold.
73	STEP 1 result chip — FIRE	Mono 700 9px, .12em · #5FD98C on green @9% · 1px solid #1E6B3D · 4/7px pad	Shows NOT A FIRE (#5C6B77 on --surface-3) when the gate rejects the image; a not-a-fire result is never scored.
74	STEP 2 marker	Mono 700 9px, .14em · #5C6B77	Second stage of the pipeline.
75	STEP 2 title — Severity score	Same as #71	Static.
76	STEP 2 body	Same as #72	Smoke, flame, damage and people proximity scored 1–4 and summed to 9 of 16.
77	STEP 2 result chip — SCORED	Mono 700 9px, .12em · #D5DFE8 on --surface-2 · 1px solid #26333F · 4/7px pad	SCORED / NOT SCORED / COORDINATOR — states whether the four element scores exist for this record.
78	Element label — Smoke level	Mono 600 11px, .08em, uppercase · #D5DFE8 · 150px column · 1px #161F28 top border	Read-only. One of four elements scored 1–4 and summed to the 4–16 total.
79	Score cell 1 (filled)	28×23px · Mono 700 10px · #7A0F16 fill · #FFFFFF numeral · 4px #FF4D4D ring · 1px ring	Filled up to the element score. Display only.
80	Score cell 2 (filled)	Same as #79	Filled up to the element score. Display only.
81	Score cell 3 (filled)	Same as #79	Filled up to the element score. Display only.
82	Score cell 4 (filled)	Same as #79	Filled up to the element score. Display only.
83	Element value — 4	Mono 700 16px · #E6EDF3	The 1–4 score for this element.
84	Element description	Sans 400 13px · #A8B6C2	Fixed rubric string: Very dense smoke, blocking vision
85	Element label — Flame visibility	Same as #78	Read-only. One of four elements scored 1–4 and summed to the 4–16 total.
86	Score cell 1 (filled)	28×23px · Mono 700 10px · #F58021 fill · #1A0C02 numeral · 2px #FFB36B ring · 1px ring	Filled up to the element score. Display only.
87	Score cell 2 (filled)	Same as #86	Filled up to the element score. Display only.
88	Score cell 3 (empty)	28×23px · Mono 700 10px · #5C6B77 text · no fill · 1px solid #26333F	Unfilled cell above the score. Display only.
89	Score cell 4 (empty)	Same as #88	Unfilled cell above the score. Display only.
90	Element value — 2	Same as #83	The 1–4 score for this element.
91	Element description	Same as #84	Fixed rubric string: Some flame visible
92	Element label — Damage / impact	Same as #78	Read-only. One of four elements scored 1–4 and summed to the 4–16 total.
93	Score cell 1 (filled)	Same as #86	Filled up to the element score. Display only.
94	Score cell 2 (filled)	Same as #86	Filled up to the element score. Display only.
95	Score cell 3 (empty)	Same as #88	Unfilled cell above the score. Display only.
96	Score cell 4 (empty)	Same as #88	Unfilled cell above the score. Display only.
97	Element value — 2	Same as #83	The 1–4 score for this element.
98	Element description	Same as #84	Fixed rubric string: Vegetation scorching, no structures at risk
99	Element label — People proximity	Same as #78	Read-only. One of four elements scored 1–4 and summed to the 4–16 total.

#	Element	Visual spec	Behaviour / interaction
100	Score cell 1 (filled)	28x23px · Mono 700 10px · #F5C842 fill · #1A1405 numeral · 2px #FFE08A ring · 1px ring	Filled up to the element score. Display only.
101	Score cell 2 (empty)	Same as #88	Unfilled cell above the score. Display only.
102	Score cell 3 (empty)	Same as #88	Unfilled cell above the score. Display only.
103	Score cell 4 (empty)	Same as #88	Unfilled cell above the score. Display only.
104	Element value — 1	Same as #83	The 1–4 score for this element.
105	Element description	Same as #84	Fixed rubric string: No people visible in range of fire
106	Total score label	Mono 600 11px, .08em, uppercase · #E6EDF3 · 1px #2C3A48 top border, 13px top pad	—
107	Range note — range 4 – 16	Same as #64	States the fixed scale.
108	Total value — 9	Mono 700 20px · #E6EDF3	Sum of the four element scores.
109	Band sentence	Sans 500 13.5px · #D5DFE8	9 falls in the 8–10 band → High.
110	Band-map dot — level 1	20px circle · Mono 700 9px · #F5C842 fill · #1A1405 numeral · 2px #FFE08A ring · 1px ring	Static reference.
111	Band-map label — 4–7 → MOD	Mono 600 10px/1.4 · #8B9AA8 · cell 1px solid #161F28	Other bands, shown for reference.
112	Band-map dot — level 2	20px circle · Mono 700 9px · #F58021 fill · #1A0C02 numeral · 2px #FFB36B ring · 1px ring	Static reference.
113	Band-map label — 8–10 → HIGH	Mono 600 10px/1.4 · #E6EDF3 · cell on --tint with a 1px #2BD9C8 border	The band this incident falls in, highlighted.
114	Band-map dot — level 3	20px circle · Mono 700 9px · #E03127 fill · #FFFFFF numeral · 3px #FF8078 ring · 1px ring	Static reference.
115	Band-map label — 11–13 → EXT	Same as #111	Other bands, shown for reference.
116	Band-map dot — level 4	20px circle · Mono 700 9px · #7A0F16 fill · #FFFFFF numeral · 4px #FF4D4D ring · 1px ring	Static reference.
117	Band-map label — 14–16 → CAT	Same as #111	Other bands, shown for reference.
118	NEARBY label	Mono 500 10px, .14em, uppercase · #8B9AA8	Labels the nearby strip.
119	NEARBY chip — INC-0428 (3.2 km)	Chip 1px solid #22303C on --panel · 6/11px pad · 20px band dot + ID Mono 600 11px #C4D0DA + distance Mono 400 11px #8B9AA8 · hover border #2BD9C8, bg --tint-2	Opens that incident detail screen.
120	NEARBY chip — INC-0431 (11.4 km)	Same as #119	Opens that incident detail screen.
121	NEARBY chip — INC-0426 (18.9 km)	Same as #119	Opens that incident detail screen.
122	Toast container	Max-width 460–500px · --panel #0C1219 · 1px solid #2C3A48 · 3px left border #2BD9C8 · 14/18px pad · shadow 0 8px 30px rgba(0,0,0,.6)	In the running app the toast is fixed at top 64px / right 20px and is non-blocking; it is shown at the foot of this figure so it does not cover the screen. Auto-clears after 5 seconds.
123	Toast dismiss ×	23px circle offset –11px/–11px outside the top-left corner · --panel · 1px solid #2C3A48 · Mono 400 11px #8B9AA8	Cancels the 5s timer and removes the toast immediately.
124	Toast icon	33px circle · Mono 700 13px · #F58021 fill · #1A0C02 numeral · 2px #FFB36B ring	Shows the resulting band. A question mark appears for review states and a null symbol for dismissals.

#	Element	Visual spec	Behaviour / interaction
125	Toast title — AI tag confirmed · INC-0433	Same as #71	Names the action and the affected id.
126	Toast body	Sans 400 12.5px · #8B9AA8	Promoted to an active incident with the provisional score applied.
127	Auto-clear indicator	52x2px track #2C3A48 with a #2BD9C8 fill animating scaleX(1→0) over 5s linear · caption Mono 400 10px #5C6B77	Visible countdown of the 5s timer: clears in 5s, dismiss sooner with ✕.
128	Toast Undo	Mono 600 10px, .12em, uppercase · #2BD9C8 · hover #7FEFE3	Reverts to the AI assessment, clears the coordinator provenance and logs Reverted to the AI assessment (undo). Available only while the toast is on screen — after 5 seconds a Confirm has no Undo.

Figure 7 — State 3 — immediately after Change (severity chip pressed)

Change follows the same navigation as Confirm. The differences are provenance (assigned manually by coordinator), the four element scores cleared to not scored, and the COORDINATOR chip in step 2. Badges 119–125 cover the toast.

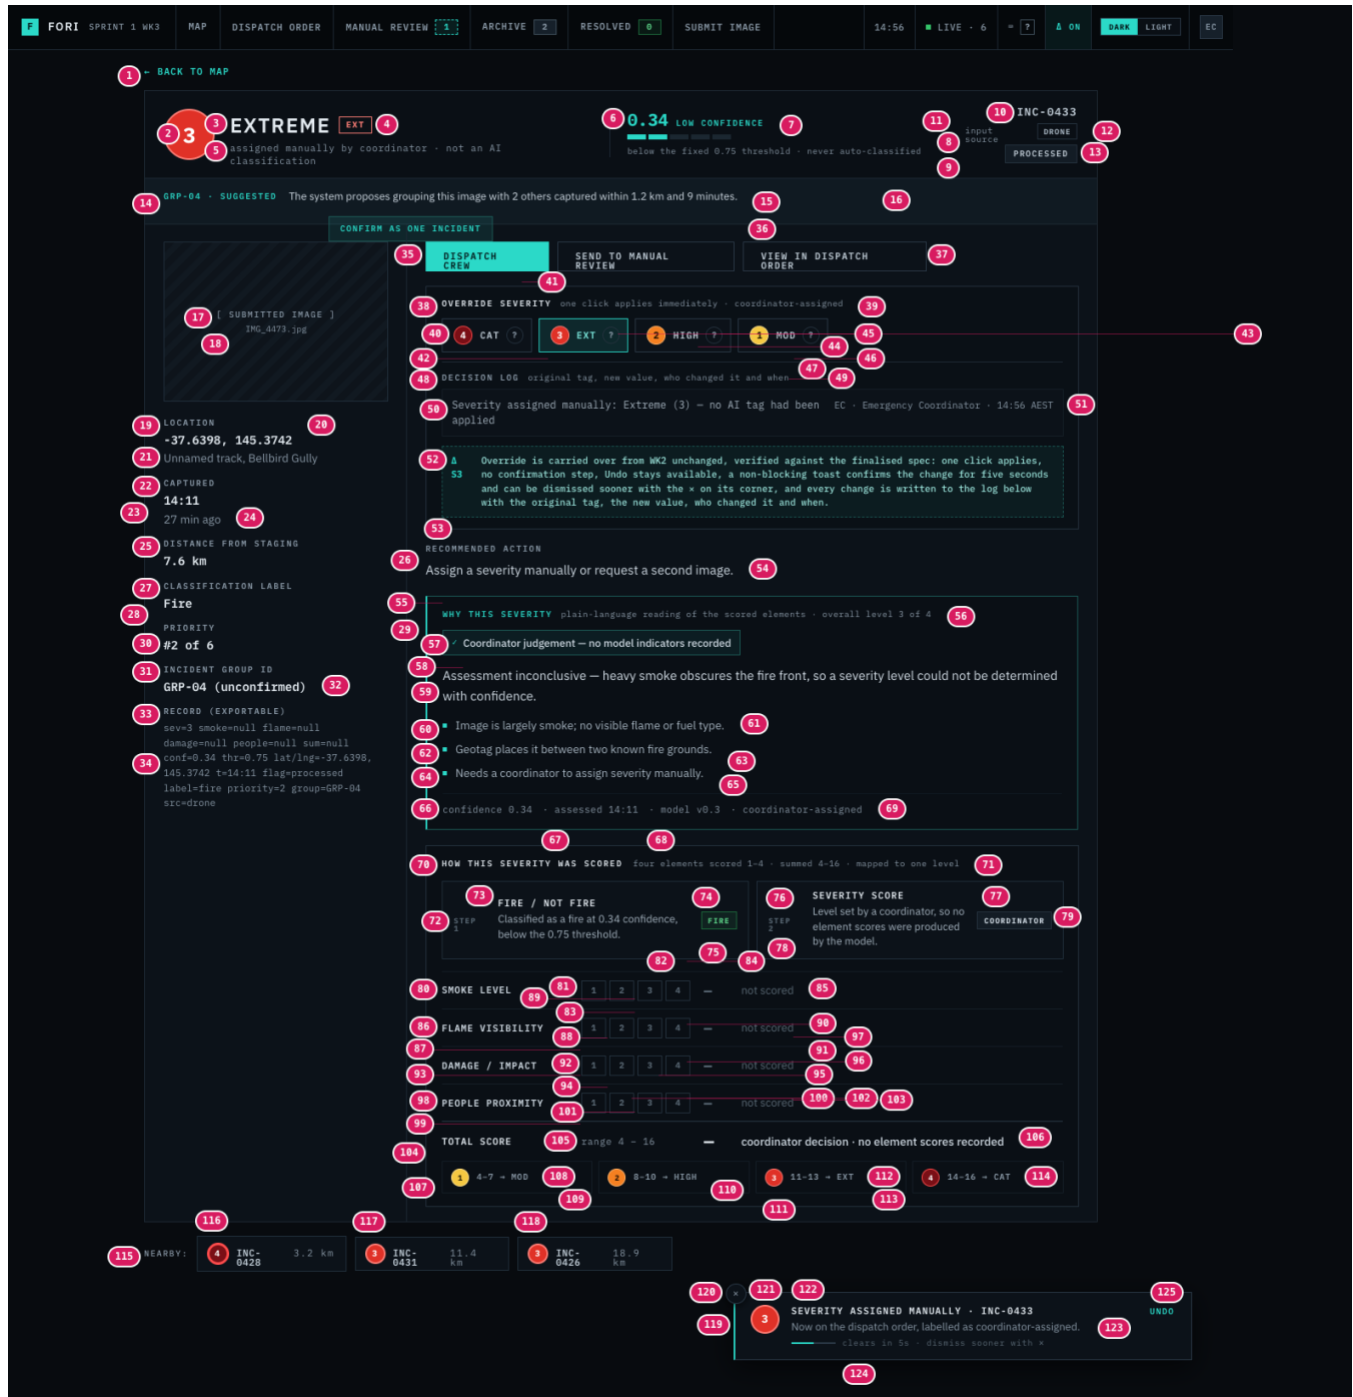

#	Element	Visual spec	Behaviour / interaction
1	← Back to map link	Mono 600 11px, .1em, uppercase · #2BD9C8 · hover #7FEFE3	Click → Map, whatever screen the user arrived from.
2	Severity numeral — 3	Mono 700 25px · #FFFFFF · inside a 64px dot (56px + 4px #FF8078 ring) with a 4px --halo outer ring	The band level 1–4, or a question mark when no severity is applied. Diameter and ring weight step with the band (26/2, 34/2, 42/3, 50/4 base).
3	Band name — Extreme	Sans 600 24px/1.1, .06em, uppercase · #E6EDF3	Derived from the applied severity.

#	Element	Visual spec	Behaviour / interaction
4	Band abbreviation chip	Mono 700 10px, .14em · #FF8078 on --halo #0A1016 · 1px solid #FF8078 · 4/7px pad	Static.
5	Provenance line	Mono 400 11px/1.4 · #8B9AA8	assigned manually by coordinator · not an AI classification — provenance is stated in words, not only in the log.
6	Confidence figure — 0.34	Mono 700 20px · #2BD9C8	The model confidence for this image. A coordinator action never changes it.
7	Confidence label — Low confidence	Mono 600 10px, .14em, uppercase · #2BD9C8	≥0.85 High confidence #35C46A · 0.75–0.84 Moderate #F5C842 · below 0.75 Low #2BD9C8.
8	Confidence segments	Five 22×6px segments · filled #2BD9C8, empty #1B2731 · 20px left pad behind a 1px --border rule	Segment count = round(confidence / 20), minimum 1.
9	Threshold note	Mono 400 10px/1.4 · #8B9AA8	below the fixed 0.75 threshold · never auto-classified
10	Incident ID — INC-0433	Mono 600 13px, .08em · #C4D0DA · right-aligned	Static.
11	input source label	Mono 400 10px · #8B9AA8	Labels the channel chip.
12	Input-source chip — DRONE	Mono 700 9px, .12em · #A8B6C2 · 1px solid #26333F · 4/6px pad · tooltip gives the full channel name	The visible per-incident record of which of the four input channels the image arrived on: MANUAL / DRONE / SAT / API.
13	Status flag chip — Processed	Mono 600 10px, .12em, uppercase · #C4D0DA on --surface-2 #131C25 · 1px solid #26333F · 5/9px pad	One flag per image at a time: Processed / Flagged · review / Not a fire / Extinguished / Dispatched.
14	Grouping banner title — GRP-04 · SUGGESTED	Mono 600 10px, .14em · #2BD9C8 · full-width band on --tint with a 1px --border bottom	Shown only for images in the proposed group. The suffix follows the group state: SUGGESTED, GROUPED, KEPT SEPARATE.
15	Grouping banner sentence	Sans 400 12.5px · #D5DFE8	States the proximity and time window behind the proposal.
16	Grouping banner action — Confirm as one incident	Mono 600 10px, .12em, uppercase · #2BD9C8 on accent @10% · 1px solid #1D5B57 · 9/12px pad	One click confirms the group and logs it; the action then becomes Split into separate incidents. Nothing is auto-committed.
17	Image placeholder frame	308px column · 186px tall · 1px #22303C · 135° hatch #0E141B / #111921 at 8px	Placeholder for the incident image.
18	Image file name	Same as #11	From the submission record.
19	Field key — LOCATION	Mono 600 10px, .16em, uppercase · #8B9AA8	Read-only field label.
20	Field value — -37.6398, 145.3742	Mono 600 14px/1.3 · #E6EDF3	Read-only.
21	Field sub-line — Unnamed track, Bellbird Gully	Sans 400 13.5px · #8B9AA8	Secondary line under the value.
22	Field key — CAPTURED	Same as #19	Read-only field label.
23	Field value — 14:11	Same as #20	Read-only.
24	Field sub-line — 27 min ago	Same as #21	Secondary line under the value.
25	Field key — DISTANCE FROM STAGING	Same as #19	Read-only field label.
26	Field value — 7.6 km	Same as #20	Read-only.
27	Field key — CLASSIFICATION LABEL	Same as #19	Read-only field label.
28	Field value — Fire	Same as #20	Resolves to Fire / Non-Fire / Extinguished / Uncertain.
29	Field key — PRIORITY	Same as #19	Read-only field label.

#	Element	Visual spec	Behaviour / interaction
30	Field value — #2 of 6	Same as #20	Resolves to #n of m, live · crew dispatched, not ranked, or resolved · not ranked.
31	Field key — INCIDENT GROUP ID	Same as #19	Read-only field label.
32	Field value — GRP-04 (unconfirmed)	Same as #20	Resolves to GRP-04, GRP-04 (unconfirmed), or none.
33	RECORD (EXPORTABLE) key	Same as #19	Labels the flat record dump.
34	Exportable record	Mono 400 11px/1.6 · #8B9AA8	sev=3 smoke=null flame=null damage=null people=null sum=null conf=0.34 thr=0.75 ... flag=processed label=fire priority=2 group=GRP-04 src=drone — a coordinator-set severity nulls all four sub-scores and the sum.
35	Dispatch crew primary button	Mono 600 11px, .12em, uppercase · #04191A on #2BD9C8 · 1px solid #2BD9C8 · 11/20px pad · hover #7FEFE3 · active #17A093	Assigns a crew: the incident moves to LIVE / DISPATCHED in the dispatch order, the flag becomes Dispatched, the button relabels to Crew dispatched ✓, and Mark extinguished and Cancel dispatch appear. Toast: Tanker 12 en route.
36	Send to manual review button	Mono 600 11px, .12em, uppercase · #C4D0DA · 1px solid #2C3A48 · 11/20px pad · hover bg --surface-2	Withdraws the applied tag, removes the incident from the ranking and the map, adds it to the review queue marked sent by coordinator, logs it and navigates to Manual Review.
37	View in dispatch order button	Same as #36	Click → Dispatch Order.
38	OVERRIDE SEVERITY heading	Mono 600 10px, .16em, uppercase · #E6EDF3 · card 1px solid #26333F on --map-bg · 15/18px pad	Section label.
39	Override state note	Same as #11	one click applies immediately · coordinator-assigned
40	Override chip CAT	Chip --panel · 1px solid #2C3A48 · 20px dot (#7A0F16 fill · #FFFFFF numeral · 4px #FF4D4D ring, 2px ring) · label Mono 600 11px, .1em, uppercase #C4D0DA · current level: bg accent @12%, 1px #2BD9C8, label #7FEFE3	One click applies severity 4 immediately — no confirmation dialog and no save step. The ranking, the map marker and the dispatch order recalculate, an Undo appears, and the change is written to the decision log with the original value, the new value, who and when.
41	Band explainer ? — CAT	19px circle · Mono 700 10px · #8B9AA8 · 1px solid #26333F · hover border and text #2BD9C8, bg accent @10%	Toggles the inline rubric panel for that band. Does not change the severity.
42	Override chip EXT	Chip --panel · 1px solid #2C3A48 · 20px dot (#E03127 fill · #FFFFFF numeral · 3px #FF8078 ring, 2px ring) · label Mono 600 11px, .1em, uppercase #C4D0DA · current level: bg accent @12%, 1px #2BD9C8, label #7FEFE3	One click applies severity 3 immediately — no confirmation dialog and no save step. The ranking, the map marker and the dispatch order recalculate, an Undo appears, and the change is written to the decision log with the original value, the new value, who and when.
43	Band explainer ? — EXT	Same as #41	Toggles the inline rubric panel for that band. Does not change the severity.
44	Override chip HIGH	Chip --panel · 1px solid #2C3A48 · 20px dot (#F58021 fill · #1A0C02 numeral · 2px #FFB36B ring, 2px ring) · label Mono 600 11px, .1em, uppercase #C4D0DA · current level: bg accent @12%, 1px #2BD9C8, label #7FEFE3	One click applies severity 2 immediately — no confirmation dialog and no save step. The ranking, the map marker and the dispatch order recalculate, an Undo appears, and the change is written to the decision log with the original value, the new value, who and when.
45	Band explainer ? — HIGH	Same as #41	Toggles the inline rubric panel for that band. Does not change the severity.
46	Override chip MOD	Chip --panel · 1px solid #2C3A48 · 20px dot (#F5C842	One click applies severity 1 immediately — no

#	Element	Visual spec	Behaviour / interaction
		fill · #1A1405 numeral · 2px #FFE08A ring, 2px ring) · label Mono 600 11px, .1em, uppercase #C4D0DA · current level: bg accent @12%, 1px #2BD9C8, label #7FEFE3	confirmation dialog and no save step. The ranking, the map marker and the dispatch order recalculate, an Undo appears, and the change is written to the decision log with the original value, the new value, who and when.
47	Band explainer ? — MOD	Same as #41	Toggles the inline rubric panel for that band. Does not change the severity.
48	DECISION LOG heading	Mono 600 10px, .16em, uppercase · #8B9AA8 · 1px --border top rule, 13px top pad	Per-incident log only. There is no cross-incident audit view in the build.
49	Decision-log note	Same as #11	original tag, new value, who changed it and when — states the shape of each entry.
50	Log entry — manual assignment	Mono 400 12px/1.5 · #A8B6C2 · row 1px #161F28 on -panel · 9/11px pad	Severity assigned manually: Extreme (3) — no AI tag had been applied.
51	Log entry who / when	Mono 400 11px · #8B9AA8 · right-aligned	EC · Emergency Coordinator · 14:56 AEST
52	Δ S3 change note	Mono 500 11px/1.5 · #9FE9E0 on accent @6% · 1px dashed #1D5B57 · Δ S3 marker Mono 700 11px #2BD9C8	Prototype commentary, not product UI. Toggled by the header Δ ON/OFF control.
53	RECOMMENDED ACTION heading	Same as #19	Section label.
54	Recommended action text	Sans 400 15px/1.5 · #D5DFE8	Assign a severity manually or request a second image.
55	WHY THIS SEVERITY heading	Mono 600 10px, .16em, uppercase · #2BD9C8 · panel 1px solid #1D5B57 with a 3px solid #2BD9C8 left border on --surface · 16/18px pad	Read-only explanation panel.
56	Why-this-severity note	Same as #11	plain-language reading of the scored elements · overall level n of 4.
57	Indicator tick	Mono 700 10px · #2BD9C8 · chip accent @7% · 1px solid #1D5B57 · 5/8px pad	Marks a model indicator that fired.
58	Indicator label — Coordinator judgement — no model indicators recorded	Sans 500 12.5px · #D5DFE8	Read-only.
59	Severity summary	Sans 400 15px/1.55 · #D5DFE8	Assessment inconclusive — heavy smoke obscures the fire front, so a severity level could not be determined with confidence.
60	Reason bullet marker	5×5px solid #2BD9C8 square	Marker for the bullet beside it.
61	Reason bullet	Sans 400 13.5px/1.55 · #A8B6C2	Image is largely smoke; no visible flame or fuel type.
62	Reason bullet marker	Same as #60	Marker for the bullet beside it.
63	Reason bullet	Same as #61	Geotag places it between two known fire grounds.
64	Reason bullet marker	Same as #60	Marker for the bullet beside it.
65	Reason bullet	Same as #61	Needs a coordinator to assign severity manually.
66	Footer — confidence	Mono 400 11px · #8B9AA8	Restates the confidence figure.
67	Footer — assessed time	Same as #66	When the assessment ran.
68	Footer — model version	Same as #66	model v0.3 — a fixed string in the prototype.
69	Footer — provenance	Same as #66	· coordinator-assigned
70	HOW THIS SEVERITY WAS SCORED heading	Mono 600 10px, .16em, uppercase · #E6EDF3 · card 1px solid #26333F on --surface	Section label.
71	Scoring note	Same as #11	four elements scored 1–4 · summed 4–16 · mapped


#	Element	Visual spec	Behaviour / interaction
			to one level.
72	STEP 1 marker	Mono 700 9px, .14em · #5C6B77 · tile 1px #22303C on --panel · 11/13px pad	States the pipeline order: the fire / not-fire gate runs before any scoring.
73	STEP 1 title — Fire / not fire	Mono 600 11px, .1em, uppercase · #E6EDF3	Static.
74	STEP 1 body	Sans 400 12.5px · #A8B6C2	Classified as a fire at 0.34 confidence, below the 0.75 threshold.
75	STEP 1 result chip — FIRE	Mono 700 9px, .12em · #5FD98C on green @9% · 1px solid #1E6B3D · 4/7px pad	Shows NOT A FIRE (#5C6B77 on --surface-3) when the gate rejects the image; a not-a-fire result is never scored.
76	STEP 2 marker	Mono 700 9px, .14em · #5C6B77	Second stage of the pipeline.
77	STEP 2 title — Severity score	Same as #73	Static.
78	STEP 2 body	Same as #74	Level set by a coordinator, so no element scores were produced by the model.
79	STEP 2 result chip — COORDINATOR	Mono 700 9px, .12em · #D5DFE8 on --surface-2 · 1px solid #26333F · 4/7px pad	Replaces SCORED when the level came from a person rather than the model.
80	Element label — Smoke level	Mono 600 11px, .08em, uppercase · #D5DFE8	Read-only.
81	Score cell 1 (empty)	28×23px · Mono 700 10px #5C6B77 · no fill · 1px solid #26333F	All four cells unfilled: a coordinator-assigned severity produces no element scores.
82	Score cell 2 (empty)	Same as #81	All four cells unfilled: a coordinator-assigned severity produces no element scores.
83	Score cell 3 (empty)	Same as #81	All four cells unfilled: a coordinator-assigned severity produces no element scores.
84	Score cell 4 (empty)	Same as #81	All four cells unfilled: a coordinator-assigned severity produces no element scores.
85	Element value — not scored	Sans 400 13px · #5C6B77	The model sub-scores are not retained in the UI once a coordinator sets the level; the exportable record writes null for all four.
86	Element label — Flame visibility	Same as #80	Read-only.
87	Score cell 1 (empty)	Same as #81	All four cells unfilled: a coordinator-assigned severity produces no element scores.
88	Score cell 2 (empty)	Same as #81	All four cells unfilled: a coordinator-assigned severity produces no element scores.
89	Score cell 3 (empty)	Same as #81	All four cells unfilled: a coordinator-assigned severity produces no element scores.
90	Score cell 4 (empty)	Same as #81	All four cells unfilled: a coordinator-assigned severity produces no element scores.
91	Element value — not scored	Same as #85	The model sub-scores are not retained in the UI once a coordinator sets the level; the exportable record writes null for all four.
92	Element label — Damage / impact	Same as #80	Read-only.
93	Score cell 1 (empty)	Same as #81	All four cells unfilled: a coordinator-assigned severity produces no element scores.
94	Score cell 2 (empty)	Same as #81	All four cells unfilled: a coordinator-assigned severity produces no element scores.

#	Element	Visual spec	Behaviour / interaction
95	Score cell 3 (empty)	Same as #81	All four cells unfilled: a coordinator-assigned severity produces no element scores.
96	Score cell 4 (empty)	Same as #81	All four cells unfilled: a coordinator-assigned severity produces no element scores.
97	Element value — not scored	Same as #85	The model sub-scores are not retained in the UI once a coordinator sets the level; the exportable record writes null for all four.
98	Element label — People proximity	Same as #80	Read-only.
99	Score cell 1 (empty)	Same as #81	All four cells unfilled: a coordinator-assigned severity produces no element scores.
100	Score cell 2 (empty)	Same as #81	All four cells unfilled: a coordinator-assigned severity produces no element scores.
101	Score cell 3 (empty)	Same as #81	All four cells unfilled: a coordinator-assigned severity produces no element scores.
102	Score cell 4 (empty)	Same as #81	All four cells unfilled: a coordinator-assigned severity produces no element scores.
103	Element value — not scored	Same as #85	The model sub-scores are not retained in the UI once a coordinator sets the level; the exportable record writes null for all four.
104	Total score label	Mono 600 11px, .08em, uppercase · #E6EDF3 · 1px #2C3A48 top border	—
105	Range note — range 4 – 16	Same as #66	States the fixed scale.
106	Total replacement line	Sans 500 13.5px · #D5DFE8	coordinator decision · no element scores recorded. The numeric total is dropped and the exportable record writes sum=null.
107	Band-map dot — level 1	20px circle · Mono 700 9px · #F5C842 fill · #1A1405 numeral · 2px #FFE08A ring · 1px ring	Static reference.
108	Band-map label — 4–7 → MOD	Mono 600 10px/1.4 · #8B9AA8 · cell 1px solid #161F28	Other bands, shown for reference.
109	Band-map dot — level 2	20px circle · Mono 700 9px · #F58021 fill · #1A0C02 numeral · 2px #FFB36B ring · 1px ring	Static reference.
110	Band-map label — 8–10 → HIGH	Same as #108	Other bands, shown for reference.
111	Band-map dot — level 3	20px circle · Mono 700 9px · #E03127 fill · #FFFFFF numeral · 3px #FF8078 ring · 1px ring	Static reference.
112	Band-map label — 11–13 → EXT	Mono 600 10px/1.4 · #E6EDF3 · cell on --tint with a 1px #2BD9C8 border	The band this incident falls in, highlighted.
113	Band-map dot — level 4	20px circle · Mono 700 9px · #7A0F16 fill · #FFFFFF numeral · 4px #FF4D4D ring · 1px ring	Static reference.
114	Band-map label — 14–16 → CAT	Same as #108	Other bands, shown for reference.
115	NEARBY label	Mono 500 10px, .14em, uppercase · #8B9AA8	Labels the nearby strip.
116	NEARBY chip — INC-0428 (3.2 km)	Chip 1px solid #22303C on --panel · 6/11px pad · 20px band dot + ID Mono 600 11px #C4D0DA + distance Mono 400 11px #8B9AA8 · hover border #2BD9C8, bg --tint-2	Opens that incident detail screen.
117	NEARBY chip — INC-0431	Same as #116	Opens that incident detail screen.

#	Element	Visual spec	Behaviour / interaction
	(11.4 km)		
118	NEARBY chip — INC-0426 (18.9 km)	Same as #116	Opens that incident detail screen.
119	Toast container	Max-width 460–500px · --panel #0C1219 · 1px solid #2C3A48 · 3px left border #2BD9C8 · 14/18px pad · shadow 0 8px 30px rgba(0,0,0,.6)	In the running app the toast is fixed at top 64px / right 20px and is non-blocking; it is shown at the foot of this figure so it does not cover the screen. Auto-clears after 5 seconds.
120	Toast dismiss ✕	23px circle offset –11px/–11px outside the top-left corner · --panel · 1px solid #2C3A48 · Mono 400 11px #8B9AA8	Cancels the 5s timer and removes the toast immediately.
121	Toast icon	36px circle · Mono 700 13px · #E03127 fill · #FFFFFF numeral · 3px #FF8078 ring	Shows the newly assigned band.
122	Toast title — Severity assigned manually · INC-0433	Same as #73	Names the action and the affected id.
123	Toast body	Sans 400 12.5px · #8B9AA8	Now on the dispatch order, labelled as coordinator-assigned.
124	Auto-clear indicator	52×2px track #2C3A48 with a #2BD9C8 fill animating scaleX(1→0) over 5s linear · caption Mono 400 10px #5C6B77	Visible countdown of the 5s timer: clears in 5s, dismiss sooner with ✕.
125	Toast Undo	Mono 600 10px, .12em, uppercase · #2BD9C8 · hover #7FEFE3	Reverts to the AI assessment and re-flags the image. Available only while the toast is on screen.

Figure 8 — State 4 — immediately after Discard

Discard keeps the reviewer on Manual Review: the queue count drops, the discarded row disappears and the next item (INC-0435, 0.41) loads automatically. Badges 105–111 cover the toast.

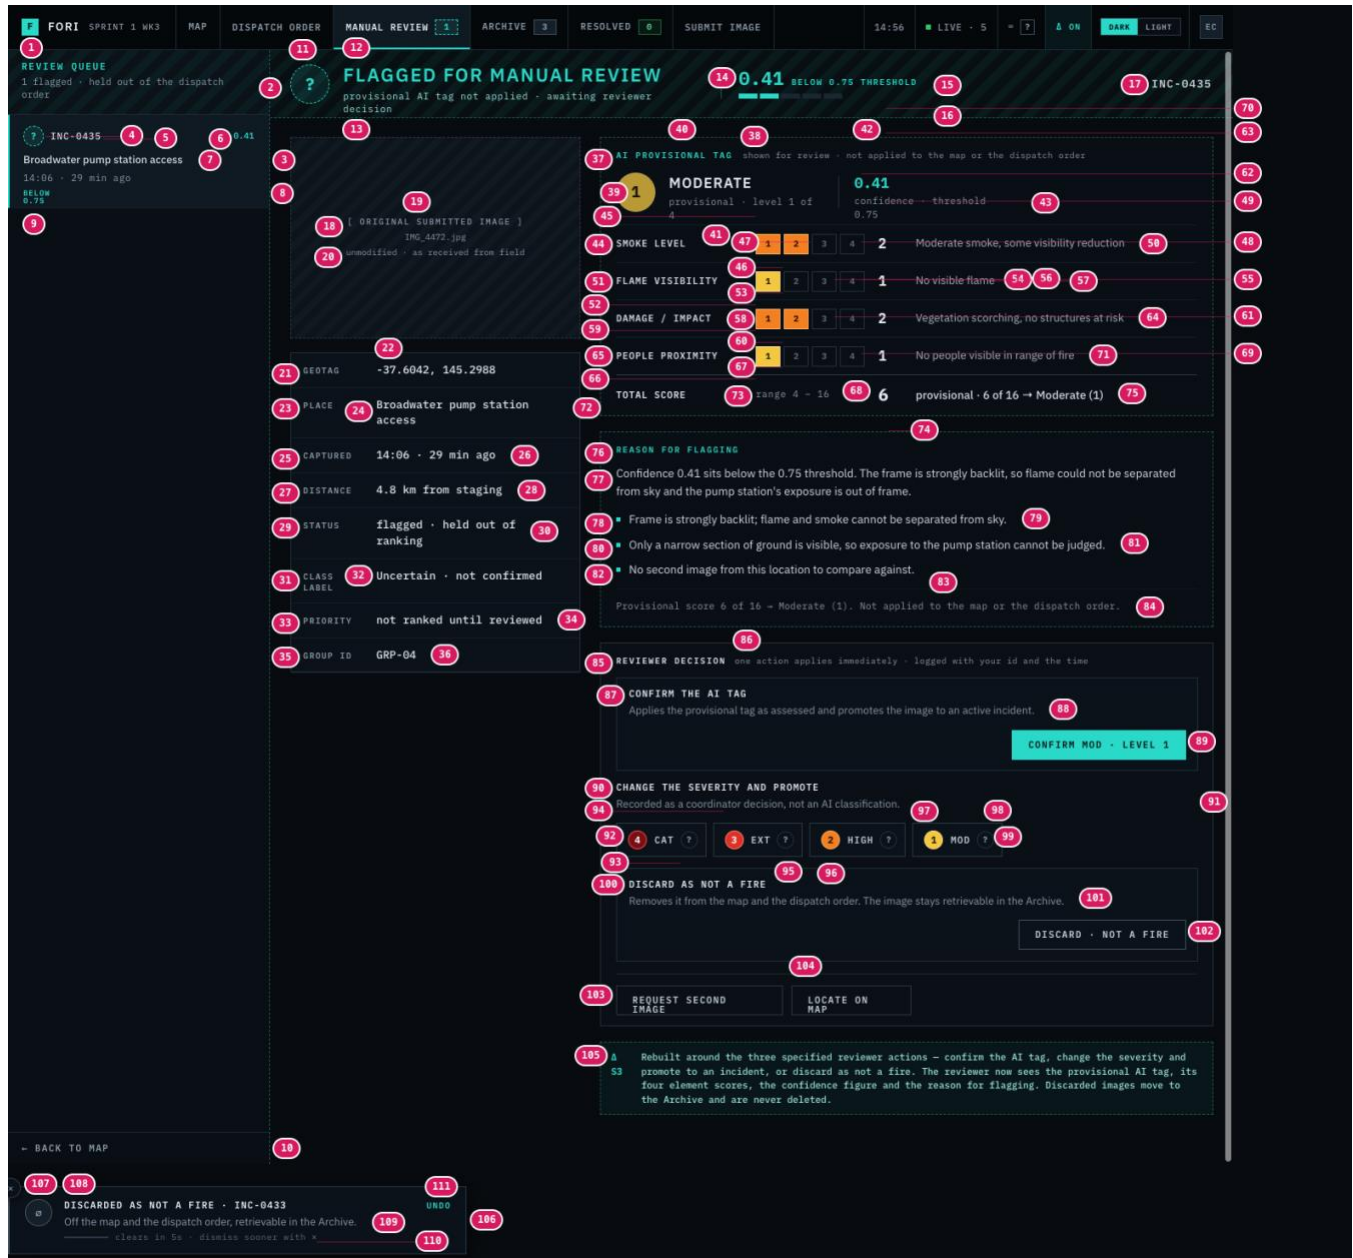

#	Element	Visual spec	Behaviour / interaction
1	Review Queue rail heading	As state 1 #1	Static.
2	Queue count line	Mono 400 11px/1.4 · #8B9AA8	Recomputed immediately after the discard: 1 flagged · held out of the dispatch order.
3	Queue row — INC-0435 (selected)	307×110px · bg --tint #101A22 · 3px solid #2BD9C8 left mark · 1px #161F28 bottom divider · hover bg --surface-2	Click loads that image into the review pane. No navigation and no change to the image state.
4	Queue flag badge	25px circle · accent @10% fill · 2px dashed #2BD9C8 · Mono 700 11px #2BD9C8 question mark	Marks the item as undecided. Never shows a severity numeral.
5	Queue image ID — INC-0435	Mono 600 11px · #C4D0DA	Static.

#	Element	Visual spec	Behaviour / interaction
6	Queue confidence — 0.41	Mono 600 10px · #2BD9C8 · right-aligned	The confidence that routed it here; always below 0.75 in this queue.
7	Queue place — Broadwater pump station access	Sans 500 12.5px · #D5DFE8	Static.
8	Queue capture line — 14:06 · 29 min ago	Mono 400 11px · #8B9AA8	Relative age advances with the clock.
9	Queue reason — below 0.75	Mono 600 9px, uppercase · #2BD9C8	Why it is in the queue. Other values: sent by coordinator; restored · was not a fire; restored · was discarded.
10	← Back to map rail footer	As state 1 #17	Click → Map.
11	Flag badge (pane)	47px circle · accent @10% fill · 2px dashed #2BD9C8 · Mono 700 20px question mark	State marker; present only while the image is undecided.
12	Banner headline — Flagged for manual review	Sans 600 22px, .08em, uppercase · #2BD9C8	One of three headlines: Flagged for manual review (below threshold), Sent for a human check (coordinator withdrew the tag), Restored for re-check (returned from the Archive).
13	Banner subline	Mono 400 11px/1.4 · #9FE9E0	provisional AI tag not applied · awaiting reviewer decision.
14	Banner confidence — 0.41	Mono 700 22px · #2BD9C8	The model confidence, restated at banner scale.
15	Threshold label — Below 0.75 threshold	Mono 600 10px, .14em, uppercase · #2BD9C8	Fixed threshold, exposed as the confidenceThreshold prop (default 75%).
16	Confidence segments	Five 22×6px segments · filled #2BD9C8, empty #1B2731 · 20px left pad behind a 1px #1D5B57 rule	Segment count = round(confidence / 20), minimum 1.
17	Image ID — INC-0435	Mono 600 13px, .08em · #C4D0DA · right-aligned	Static.
18	Image placeholder frame	340×236px · 1px dashed #2C3A48 · 135° hatch #0E141B / #111921 at 8px · caption Mono 500 10px #8B9AA8	Placeholder for the submitted image.
19	Image file name — IMG_4472.jpg	Mono 400 10px · #8B9AA8	From the submission record.
20	Image caption — unmodified · as received from field	Same as #19	States that the reviewed frame has had no processing applied.
21	Field key — GEOTAG	Mono 600 10px, .12em, uppercase · #8B9AA8	Metadata card: 1px #22303C on --panel, rows 11/14px pad, 1px #161F28 dividers, 74px key column.
22	Field value — -37.6042, 145.2988	Mono 500 13px · #E6EDF3	Read-only.
23	Field key — PLACE	Same as #21	Metadata card: 1px #22303C on --panel, rows 11/14px pad, 1px #161F28 dividers, 74px key column.
24	Field value — Broadwater pump station access	Same as #22	Read-only.
25	Field key — CAPTURED	Same as #21	Metadata card: 1px #22303C on --panel, rows 11/14px pad, 1px #161F28 dividers, 74px key column.
26	Field value — 14:06 · 29 min ago	Same as #22	Read-only.
27	Field key — DISTANCE	Same as #21	Metadata card: 1px #22303C on --panel, rows 11/14px pad, 1px #161F28 dividers, 74px key column.
28	Field value — 4.8 km from staging	Same as #22	Read-only.

#	Element	Visual spec	Behaviour / interaction
29	Field key — STATUS	Same as #21	Metadata card: 1px #22303C on --panel, rows 11/14px pad, 1px #161F28 dividers, 74px key column.
30	Field value — flagged · held out of ranking	Same as #22	Reflects the status flag Flagged for Manual Review: the image is held out of the map and the ranking.
31	Field key — CLASS LABEL	Same as #21	Metadata card: 1px #22303C on --panel, rows 11/14px pad, 1px #161F28 dividers, 74px key column.
32	Field value — Uncertain · not confirmed	Same as #22	Classification label while unresolved; resolves to Fire / Non-Fire / Extinguished after a decision.
33	Field key — PRIORITY	Same as #21	Metadata card: 1px #22303C on --panel, rows 11/14px pad, 1px #161F28 dividers, 74px key column.
34	Field value — not ranked until reviewed	Same as #22	Flagged images are never given a queue position.
35	Field key — GROUP ID	Same as #21	Metadata card: 1px #22303C on --panel, rows 11/14px pad, 1px #161F28 dividers, 74px key column.
36	Field value — GRP-04	Same as #22	Reads none when the image is not in a proposed group.
37	AI PROVISIONAL TAG heading	Mono 600 10px, .16em, uppercase · #2BD9C8 · card 1px dashed #1D5B57 on --surface · 16/18px pad	Names the withheld tag so it cannot be mistaken for an applied severity.
38	Provisional-tag note	Same as #19	shown for review · not applied to the map or the dispatch order.
39	Provisional severity numeral — 1	Mono 700 18px · inside a 47px dot: #F5C842 fill · #1A1405 numeral · 2px #FFE08A ring · 2px DASHED ring · opacity .75	The dashed ring and 75% opacity are the only cues separating a provisional dot from an applied one.
40	Provisional band name — Moderate	Sans 600 17px, uppercase · #E6EDF3	Derived from the element sum; not stored.
41	Provisional level line — provisional · level 1 of 4	Same as #8	States the band position without applying it.
42	Provisional confidence — 0.41	Mono 700 17px · #2BD9C8 · behind a 1px #26333F rule	Second instance of the confidence figure, beside the tag it qualifies.
43	Confidence caption — confidence · threshold 0.75	Same as #8	Names the comparison being made.
44	Element label — Smoke level	Mono 600 11px, .08em, uppercase · #D5DFE8 · 150px column · 1px #161F28 top border	Read-only. One of four elements scored 1–4 and summed to the 4–16 total.
45	Score cell 1 (filled)	28×23px · Mono 700 10px · #F58021 fill · #1A0C02 numeral · 2px #FFB36B ring · 1px ring	Filled up to the element score. Display only.
46	Score cell 2 (filled)	Same as #45	Filled up to the element score. Display only.
47	Score cell 3 (empty)	28×23px · Mono 700 10px · #5C6B77 text · no fill · 1px solid #26333F	Unfilled cell above the score. Display only.
48	Score cell 4 (empty)	Same as #47	Unfilled cell above the score. Display only.
49	Element value — 2	Mono 700 16px · #E6EDF3	The 1–4 score for this element.
50	Element description	Sans 400 13px · #A8B6C2	Fixed rubric string: Moderate smoke, some visibility reduction
51	Element label — Flame visibility	Same as #44	Read-only. One of four elements scored 1–4 and summed to the 4–16 total.
52	Score cell 1 (filled)	28×23px · Mono 700 10px · #F5C842 fill · #1A1405 numeral · 2px #FFE08A ring · 1px ring	Filled up to the element score. Display only.

#	Element	Visual spec	Behaviour / interaction
53	Score cell 2 (empty)	Same as #47	Unfilled cell above the score. Display only.
54	Score cell 3 (empty)	Same as #47	Unfilled cell above the score. Display only.
55	Score cell 4 (empty)	Same as #47	Unfilled cell above the score. Display only.
56	Element value — 1	Same as #49	The 1–4 score for this element.
57	Element description	Same as #50	Fixed rubric string: No visible flame
58	Element label — Damage / impact	Same as #44	Read-only. One of four elements scored 1–4 and summed to the 4–16 total.
59	Score cell 1 (filled)	Same as #45	Filled up to the element score. Display only.
60	Score cell 2 (filled)	Same as #45	Filled up to the element score. Display only.
61	Score cell 3 (empty)	Same as #47	Unfilled cell above the score. Display only.
62	Score cell 4 (empty)	Same as #47	Unfilled cell above the score. Display only.
63	Element value — 2	Same as #49	The 1–4 score for this element.
64	Element description	Same as #50	Fixed rubric string: Vegetation scorching, no structures at risk
65	Element label — People proximity	Same as #44	Read-only. One of four elements scored 1–4 and summed to the 4–16 total.
66	Score cell 1 (filled)	Same as #52	Filled up to the element score. Display only.
67	Score cell 2 (empty)	Same as #47	Unfilled cell above the score. Display only.
68	Score cell 3 (empty)	Same as #47	Unfilled cell above the score. Display only.
69	Score cell 4 (empty)	Same as #47	Unfilled cell above the score. Display only.
70	Element value — 1	Same as #49	The 1–4 score for this element.
71	Element description	Same as #50	Fixed rubric string: No people visible in range of fire
72	Total score label	Mono 600 11px, .08em, uppercase · #E6EDF3 · 1px #2C3A48 top border, 13px top pad	—
73	Range note — range 4 – 16	Same as #8	States the fixed scale.
74	Total value — 6	Mono 700 20px · #E6EDF3	Sum of the four element scores.
75	Band sentence	Sans 500 13.5px · #D5DFE8	provisional · 6 of 16 → Moderate (1).
76	REASON FOR FLAGGING heading	Mono 600 10px, .16em, uppercase · #2BD9C8 · card 1px dashed #1D5B57 on --surface	Section label.
77	Flagging reason prose	Sans 400 13.5px/1.55 · #D5DFE8 · text-wrap: pretty	Confidence 0.41 sits below the 0.75 threshold. The frame is backlit, so the model could not separate flame from smoke or read the exposure around the pump station.
78	Reason bullet marker	5×5px solid #2BD9C8 square	Marker for the bullet beside it.
79	Reason bullet	Sans 400 13.5px/1.55 · #D5DFE8	Frame is strongly backlit; flame and smoke cannot be separated reliably.
80	Reason bullet marker	Same as #78	Marker for the bullet beside it.
81	Reason bullet	Same as #79	Only a narrow section of ground is visible, so damage extent cannot be judged.
82	Reason bullet marker	Same as #78	Marker for the bullet beside it.
83	Reason bullet	Same as #79	No second image from this location to compare against.


#	Element	Visual spec	Behaviour / interaction
84	Withheld-score note	Mono 400 11px/1.5 · #8B9AA8 · 1px --tint top border, 11px top pad	Provisional score 6 of 16 → Moderate (1). Not applied to the map or the dispatch order.
85	REVIEWER DECISION heading	Mono 600 10px, .16em, uppercase · #E6EDF3 · card 1px solid #26333F on --map-bg #0A1016	Separates the decision area from the evidence above it.
86	Decision note	Same as #19	one action applies immediately · logged with your id and the time — states that there is no confirmation step.
87	Confirm block label — Confirm the AI tag	Mono 600 11px, .1em, uppercase · #E6EDF3 · inner panel 1px #22303C on --panel · 13/14px pad	Static.
88	Confirm block description	Sans 400 12.5px · #8B9AA8	Applies the provisional tag as assessed and promotes the image to an active incident.
89	CONFIRM button — reviewer action 1 — Confirm MOD · level 1	Mono 600 11px, .12em, uppercase · #04191A on #2BD9C8 · 1px solid #2BD9C8 · 11/18px pad · hover #7FEFE3 · active #17A093 · label is dynamic (band + level) · focus 2px #7FEFE3 outline at 3px offset	REVIEWER ACTION 1. Applies the provisional band as final and promotes the image to an active incident. Status flag → Processed. Writes AI provisional tag confirmed: Moderate (1), scored 6 of 16 to the decision log with the coordinator id and the time. The screen then LEAVES Manual Review for Incident Detail and raises the AI tag confirmed toast.
90	Change block label — Change the severity and promote	Mono 600 11px, .1em, uppercase · #E6EDF3	Static.
91	Change block description	Same as #88	Recorded as a coordinator decision, not an AI classification.
92	Severity chip CAT — reviewer action 2	Chip --panel · 1px solid #2C3A48 · 7/13px pad · 20px dot (#7A0F16 fill · #FFFFFF numeral · 4px #FF4D4D ring, 2px ring) · label Mono 600 11px, .1em, uppercase #C4D0DA · selected: bg accent @12%, 1px #2BD9C8, label #7FEFE3	REVIEWER ACTION 2 (one of four chips). One click sets severity 4 and promotes the image. The four element scores are cleared to not scored, the record is marked coordinator-assigned, the log records Severity assigned manually, the flag becomes Processed, and the screen moves to Incident Detail with a toast. Chips run 4 → 1, so Change is four buttons rather than one (see Open items).
93	Band explainer ? — CAT	19px circle · Mono 700 10px · #8B9AA8 · 1px solid #26333F · hover border and text #2BD9C8, bg accent @10%	Toggles an inline rubric panel giving the band name, level n of 4 and its plain-language definition. One open at a time; does not change the severity.
94	Severity chip EXT — reviewer action 2	Chip --panel · 1px solid #2C3A48 · 7/13px pad · 20px dot (#E03127 fill · #FFFFFF numeral · 3px #FF8078 ring, 2px ring) · label Mono 600 11px, .1em, uppercase #C4D0DA · selected: bg accent @12%, 1px #2BD9C8, label #7FEFE3	REVIEWER ACTION 2 (one of four chips). One click sets severity 3 and promotes the image. The four element scores are cleared to not scored, the record is marked coordinator-assigned, the log records Severity assigned manually, the flag becomes Processed, and the screen moves to Incident Detail with a toast. Chips run 4 → 1, so Change is four buttons rather than one (see Open items).
95	Band explainer ? — EXT	Same as #93	Toggles an inline rubric panel giving the band name, level n of 4 and its plain-language definition. One open at a time; does not change the severity.
96	Severity chip HIGH — reviewer action 2	Chip --panel · 1px solid #2C3A48 · 7/13px pad · 20px dot (#F58021 fill · #1A0C02 numeral · 2px #FFB36B ring, 2px ring) · label Mono 600 11px, .1em, uppercase #C4D0DA · selected: bg accent @12%, 1px #2BD9C8, label #7FEFE3	REVIEWER ACTION 2 (one of four chips). One click sets severity 2 and promotes the image. The four element scores are cleared to not scored, the record is marked coordinator-assigned, the log records Severity assigned manually, the flag becomes Processed, and the screen moves to Incident Detail with a toast. Chips run 4 → 1, so Change is four buttons rather than one (see Open items).
97	Band explainer ? — HIGH	Same as #93	Toggles an inline rubric panel giving the band name,

#	Element	Visual spec	Behaviour / interaction
			level n of 4 and its plain-language definition. One open at a time; does not change the severity.
98	Severity chip MOD — reviewer action 2	Chip --panel · 1px solid #2C3A48 · 7/13px pad · 20px dot (#F5C842 fill · #1A1405 numeral · 2px #FFE08A ring, 2px ring) · label Mono 600 11px, .1em, uppercase #C4D0DA · selected: bg accent @12%, 1px #2BD9C8, label #7FEFE3	REVIEWER ACTION 2 (one of four chips). One click sets severity 1 and promotes the image. The four element scores are cleared to not scored, the record is marked coordinator-assigned, the log records Severity assigned manually, the flag becomes Processed, and the screen moves to Incident Detail with a toast. Chips run 4 → 1, so Change is four buttons rather than one (see Open items).
99	Band explainer ? — MOD	Same as #93	Toggles an inline rubric panel giving the band name, level n of 4 and its plain-language definition. One open at a time; does not change the severity.
100	Discard block label — Discard as not a fire	Same as #90	Static.
101	Discard block description	Same as #88	Removes it from the map and the dispatch order. The image stays retrievable in the Archive.
102	DISCARD button — reviewer action 3	Mono 600 11px, .12em, uppercase · #C4D0DA · transparent · 1px solid #42525F · 11/18px pad · hover bg --surface-2	REVIEWER ACTION 3. Marks the image Not a Fire, removes it from the map and the dispatch order, records the dismissal (reason, who, time) and moves the record to the Archive. Unlike Confirm and Change it STAYS on Manual Review and loads the next queue item.
103	Request second image button	Mono 600 11px, .12em, uppercase · #C4D0DA · 1px solid #2C3A48 · 11/18px pad · hover bg --surface-2	Raises a Second image requested toast. The image keeps its flagged status and stays in the queue. Not one of the three specified reviewer actions (see Open items).
104	Locate on map button	Same as #103	Switches to the Map at zoom 3 and pulses the marker — but a flagged image has no marker until it is confirmed, so there is nothing to pulse (see Open items).
105	Δ S3 change note	Mono 500 11px/1.5 · #9FE9E0 on accent @6% · 1px dashed #1D5B57 · Δ S3 marker Mono 700 11px #2BD9C8	Prototype commentary, not product UI. Toggled by the header Δ ON/OFF control.
106	Toast container	Max-width 460–500px · --panel #0C1219 · 1px solid #2C3A48 · 3px left border #42525F · 14/18px pad · shadow 0 8px 30px rgba(0,0,0,.6)	In the running app the toast is fixed at top 64px / right 20px and is non-blocking; it is shown at the foot of this figure so it does not cover the screen. Auto-clears after 5 seconds. The × dismiss control sits in the toast's top-left corner (23px circle, --panel, 1px solid #2C3A48, Mono 400 11px #8B9AA8) and cancels the timer immediately; on this toast it is not drawn as a separate numbered element.
107	Toast icon	32px circle · Mono 700 13px #8B9AA8 on --surface-3 #16202A · 1px solid #42525F · null symbol	The dismissal icon; the toast left border also switches from accent to #42525F.
108	Toast title — Discarded as not a fire · INC-0433	Same as #90	Names the action and the affected id.
109	Toast body	Same as #88	Off the map and the dispatch order, retrievable in the Archive.
110	Auto-clear indicator	52×2px track #2C3A48 with a #2BD9C8 fill animating scaleX(1→0) over 5s linear · caption Mono 400 10px #5C6B77	Visible countdown of the 5s timer: clears in 5s, dismiss sooner with ×.
111	Toast Undo	Mono 600 10px, .12em, uppercase · #2BD9C8 · hover	Restores the image to the review queue with its

#	Element	Visual spec	Behaviour / interaction
		#7FEFE3	provisional tag intact and writes Restored from the archive to manual review to the log. The dismissal itself stays on the record.

Figure 9 — State 5 — empty queue

Shown when no detection sits below the threshold. Captured at its natural content height; in the running app the rail and pane fill the viewport.

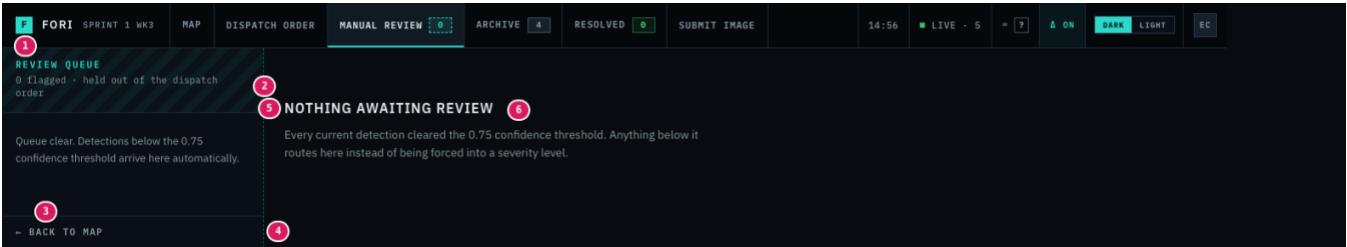


#	Element	Visual spec	Behaviour / interaction
1	Review Queue rail heading	Mono 600 11px, .16em, uppercase · #2BD9C8 · hatch and dashed right border retained	The rail, its hatch and its footer stay in place when the queue is clear.
2	Queue count line — 0 flagged	Mono 400 11px/1.4 · #8B9AA8	Reads 0 flagged · held out of the dispatch order.
3	Rail empty message	Sans 400 12.5px/1.6 · #8B9AA8 · 22/16px pad	Queue clear. Detections below the 0.75 confidence threshold arrive here automatically.
4	← Back to map rail footer	Mono 600 11px, .12em, uppercase · #8B9AA8 · 1px #1F2A35 top border	Click → Map.
5	Pane empty heading — Nothing awaiting review	Sans 600 16px/1.3, .06em, uppercase · #E6EDF3 · block max-width 520px · 60/24px pad	No illustration and no call to action.
6	Threshold figure inside the empty body — 0.75	Sans 400 13.5px · #8B9AA8 (inline within the paragraph)	The paragraph reads: Every current detection cleared the 0.75 confidence threshold. Anything below it routes here instead of being forced into a severity level. The figure is driven by the confidenceThreshold prop.

Incident Detail

One scrolling page, max-width 1120 px, centred on --bg: header band, optional grouping banner, then a 308 px / 1fr two-column body inside a 1 px --border panel, with the NEARBY strip below. Two states are documented: a standard AI-classified incident, and the moment after a severity override (which is also the override, toast, Undo and decision-log specification).

Figure 10 — State 1 — AI-classified incident, awaiting dispatch (INC-0428)

Reached from a map marker, a ranked list row, a dispatch-order row, a NEARBY chip or a group member chip.

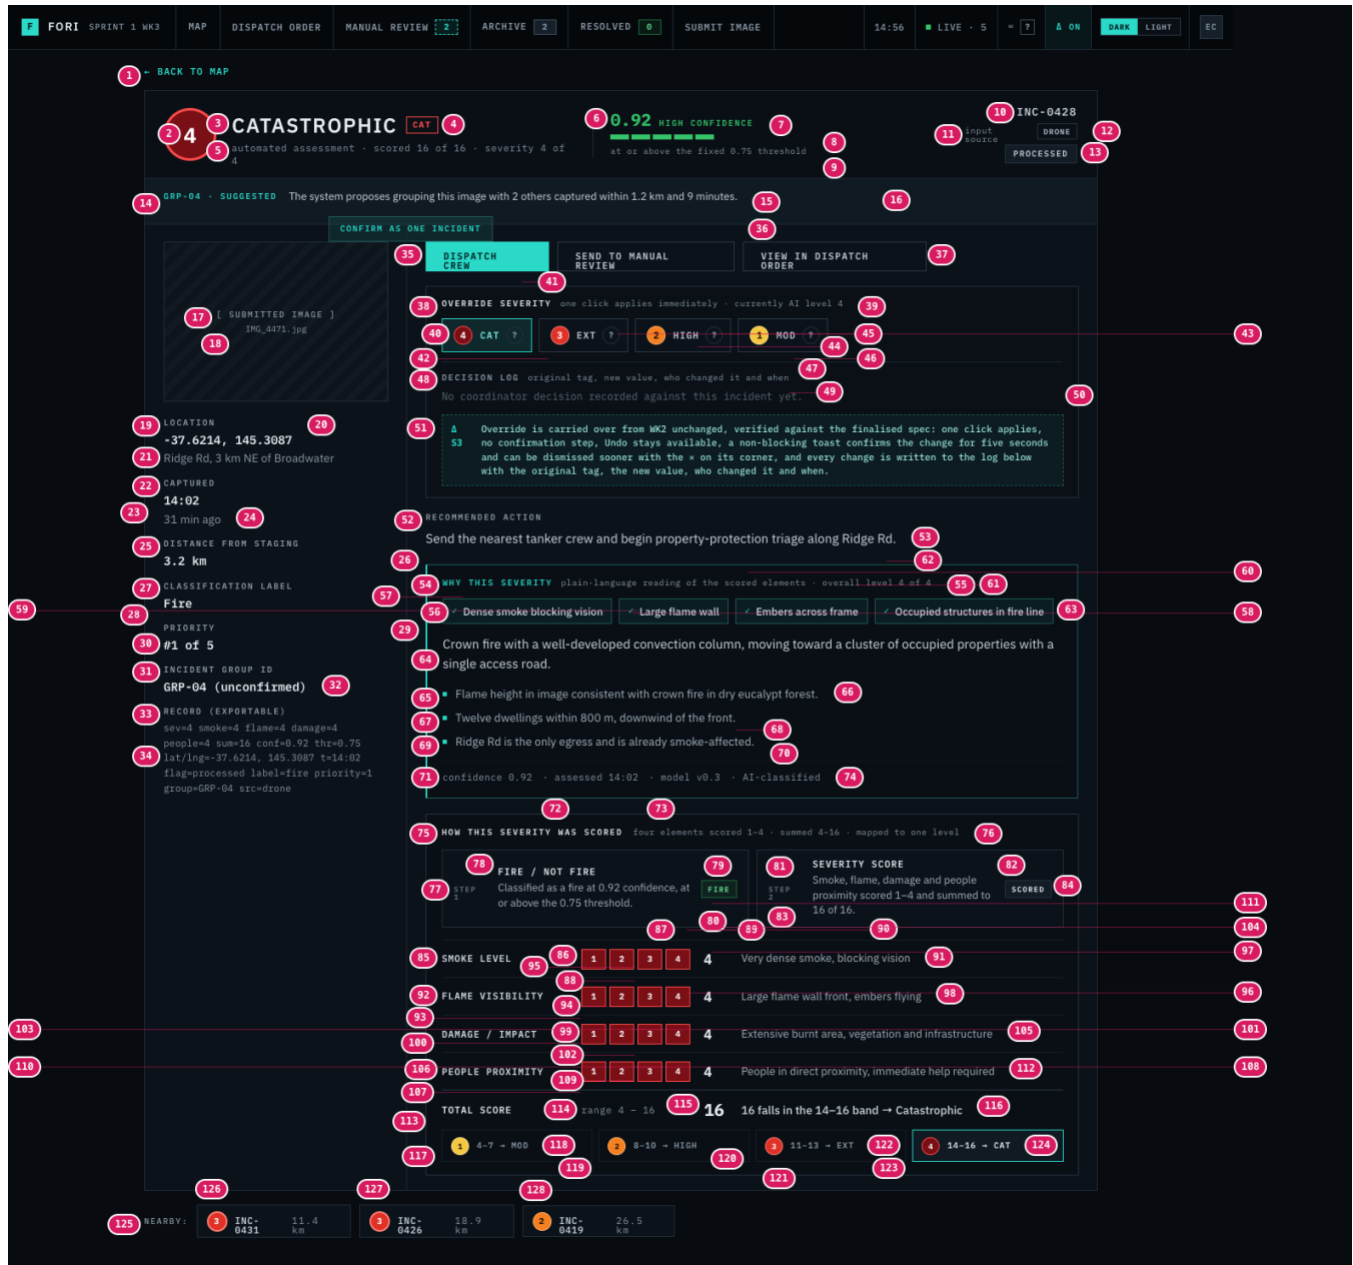

#	Element	Visual spec	Behaviour / interaction
1	← Back to map link	Mono 600 11px, .1em, uppercase · #2BD9C8 · hover #7FEFE3	Click → Map, whatever screen the user arrived from.
2	Severity numeral — 4	Mono 700 25px · #FFFFFF · inside a 64px dot (56px + 4px #FF4D4D ring) with a 4px --halo outer ring	The band level 1–4, or a question mark when no severity is applied. Diameter and ring weight step with the band (26/2, 34/2, 42/3, 50/4 base).

#	Element	Visual spec	Behaviour / interaction
3	Band name — Catastrophic	Sans 600 24px/1.1, .06em, uppercase · #E6EDF3	Derived from the applied severity.
4	Band abbreviation chip	Mono 700 10px, .14em · #FF4D4D on --halo #0A1016 · 1px solid #FF4D4D · 4/7px pad	Static.
5	Provenance line	Mono 400 11px/1.4 · #8B9AA8	automated assessment · scored 16 of 16 · severity 4 of 4
6	Confidence figure — 0.92	Mono 700 20px · #35C46A	The model confidence for this image. A coordinator action never changes it.
7	Confidence label — High confidence	Mono 600 10px, .14em, uppercase · #35C46A	≥0.85 High confidence #35C46A · 0.75–0.84 Moderate #F5C842 · below 0.75 Low #2BD9C8.
8	Confidence segments	Five 22×6px segments · filled #35C46A, empty #1B2731 · 20px left pad behind a 1px --border rule	Segment count = round(confidence / 20), minimum 1.
9	Threshold note	Mono 400 10px/1.4 · #8B9AA8	at or above the fixed 0.75 threshold
10	Incident ID — INC-0428	Mono 600 13px, .08em · #C4D0DA · right-aligned	Static.
11	input source label	Mono 400 10px · #8B9AA8	Labels the channel chip.
12	Input-source chip — DRONE	Mono 700 9px, .12em · #A8B6C2 · 1px solid #26333F · 4/6px pad · tooltip gives the full channel name	The visible per-incident record of which of the four input channels the image arrived on: MANUAL / DRONE / SAT / API.
13	Status flag chip — Processed	Mono 600 10px, .12em, uppercase · #C4D0DA on --surface-2 #131C25 · 1px solid #26333F · 5/9px pad	One flag per image at a time: Processed / Flagged · review / Not a fire / Extinguished / Dispatched.
14	Grouping banner title — GRP-04 · SUGGESTED	Mono 600 10px, .14em · #2BD9C8 · full-width band on --tint with a 1px --border bottom	Shown only for images in the proposed group. The suffix follows the group state: SUGGESTED, GROUPED, KEPT SEPARATE.
15	Grouping banner sentence	Sans 400 12.5px · #D5DFE8	States the proximity and time window behind the proposal.
16	Grouping banner action — Confirm as one incident	Mono 600 10px, .12em, uppercase · #2BD9C8 on accent @10% · 1px solid #1D5B57 · 9/12px pad	One click confirms the group and logs it; the action then becomes Split into separate incidents. Nothing is auto-committed.
17	Image placeholder frame	308px column · 186px tall · 1px #22303C · 135° hatch #0E141B / #111921 at 8px	Placeholder for the incident image.
18	Image file name	Same as #11	From the submission record.
19	Field key — LOCATION	Mono 600 10px, .16em, uppercase · #8B9AA8	Read-only field label.
20	Field value — -37.6214, 145.3087	Mono 600 14px/1.3 · #E6EDF3	Read-only.
21	Field sub-line — Ridge Rd, 3 km NE of Broadwater	Sans 400 13.5px · #8B9AA8	Secondary line under the value.
22	Field key — CAPTURED	Same as #19	Read-only field label.
23	Field value — 14:02	Same as #20	Read-only.
24	Field sub-line — 31 min ago	Same as #21	Secondary line under the value.
25	Field key — DISTANCE FROM STAGING	Same as #19	Read-only field label.
26	Field value — 3.2 km	Same as #20	Read-only.
27	Field key — CLASSIFICATION LABEL	Same as #19	Read-only field label.
28	Field value — Fire	Same as #20	Resolves to Fire / Non-Fire / Extinguished / Uncertain.
29	Field key — PRIORITY	Same as #19	Read-only field label.

#	Element	Visual spec	Behaviour / interaction
30	Field value — #1 of 5	Same as #20	Resolves to #n of m, live · crew dispatched, not ranked, or resolved · not ranked.
31	Field key — INCIDENT GROUP ID	Same as #19	Read-only field label.
32	Field value — GRP-04 (unconfirmed)	Same as #20	Resolves to GRP-04, GRP-04 (unconfirmed), or none.
33	RECORD (EXPORTABLE) key	Same as #19	Labels the flat record dump.
34	Exportable record	Mono 400 11px/1.6 · #8B9AA8	sev=4 smoke=4 flame=4 damage=4 people=4 sum=16 conf=0.92 thr=0.75 lat/lng=-37.6214, 145.3087 t=14:02 flag=processed label=fire priority=1 group=GRP-04 src=drone — the intended handover shape of one incident. Nulls appear as null.
35	Dispatch crew primary button	Mono 600 11px, .12em, uppercase · #04191A on #2BD9C8 · 1px solid #2BD9C8 · 11/20px pad · hover #7FEFE3 · active #17A093	Assigns a crew: the incident moves to LIVE / DISPATCHED in the dispatch order, the flag becomes Dispatched, the button relabels to Crew dispatched ✓, and Mark extinguished and Cancel dispatch appear. Toast: Tanker 12 en route.
36	Send to manual review button	Mono 600 11px, .12em, uppercase · #C4D0DA · 1px solid #2C3A48 · 11/20px pad · hover bg --surface-2	Withdraws the applied tag, removes the incident from the ranking and the map, adds it to the review queue marked sent by coordinator, logs it and navigates to Manual Review.
37	View in dispatch order button	Same as #36	Click → Dispatch Order.
38	OVERRIDE SEVERITY heading	Mono 600 10px, .16em, uppercase · #E6EDF3 · card 1px solid #26333F on --map-bg · 15/18px pad	Section label.
39	Override state note	Same as #11	one click applies immediately · currently AI level 4
40	Override chip CAT	Chip --panel · 1px solid #2C3A48 · 20px dot (#7A0F16 fill · #FFFFFF numeral · 4px #FF4D4D ring, 2px ring) · label Mono 600 11px, .1em, uppercase #C4D0DA · current level: bg accent @12%, 1px #2BD9C8, label #7FEFE3	One click applies severity 4 immediately — no confirmation dialog and no save step. The ranking, the map marker and the dispatch order recalculate, an Undo appears, and the change is written to the decision log with the original value, the new value, who and when.
41	Band explainer ? — CAT	19px circle · Mono 700 10px · #8B9AA8 · 1px solid #26333F · hover border and text #2BD9C8, bg accent @10%	Toggles the inline rubric panel for that band. Does not change the severity.
42	Override chip EXT	Chip --panel · 1px solid #2C3A48 · 20px dot (#E03127 fill · #FFFFFF numeral · 3px #FF8078 ring, 2px ring) · label Mono 600 11px, .1em, uppercase #C4D0DA · current level: bg accent @12%, 1px #2BD9C8, label #7FEFE3	One click applies severity 3 immediately — no confirmation dialog and no save step. The ranking, the map marker and the dispatch order recalculate, an Undo appears, and the change is written to the decision log with the original value, the new value, who and when.
43	Band explainer ? — EXT	Same as #41	Toggles the inline rubric panel for that band. Does not change the severity.
44	Override chip HIGH	Chip --panel · 1px solid #2C3A48 · 20px dot (#F58021 fill · #1A0C02 numeral · 2px #FFB36B ring, 2px ring) · label Mono 600 11px, .1em, uppercase #C4D0DA · current level: bg accent @12%, 1px #2BD9C8, label #7FEFE3	One click applies severity 2 immediately — no confirmation dialog and no save step. The ranking, the map marker and the dispatch order recalculate, an Undo appears, and the change is written to the decision log with the original value, the new value, who and when.
45	Band explainer ? — HIGH	Same as #41	Toggles the inline rubric panel for that band. Does not change the severity.
46	Override chip MOD	Chip --panel · 1px solid #2C3A48 · 20px dot (#F5C842	One click applies severity 1 immediately — no

#	Element	Visual spec	Behaviour / interaction
		fill · #1A1405 numeral · 2px #FFE08A ring, 2px ring) · label Mono 600 11px, .1em, uppercase #C4D0DA · current level: bg accent @12%, 1px #2BD9C8, label #7FEFE3	confirmation dialog and no save step. The ranking, the map marker and the dispatch order recalculate, an Undo appears, and the change is written to the decision log with the original value, the new value, who and when.
47	Band explainer ? — MOD	Same as #41	Toggles the inline rubric panel for that band. Does not change the severity.
48	DECISION LOG heading	Mono 600 10px, .16em, uppercase · #8B9AA8 · 1px -- border top rule, 13px top pad	Per-incident log only. There is no cross-incident audit view in the build.
49	Decision-log note	Same as #11	original tag, new value, who changed it and when — states the shape of each entry.
50	Decision-log empty state	Mono 400 12px/1.5 · #5C6B77	No coordinator decision recorded against this incident yet.
51	Δ S3 change note	Mono 500 11px/1.5 · #9FE9E0 on accent @6% · 1px dashed #1D5B57 · Δ S3 marker Mono 700 11px #2BD9C8	Prototype commentary, not product UI. Toggled by the header Δ ON/OFF control.
52	RECOMMENDED ACTION heading	Same as #19	Section label.
53	Recommended action text	Sans 400 15px/1.5 · #D5DFE8	Send the nearest tanker crew and begin property protection on Ridge Rd.
54	WHY THIS SEVERITY heading	Mono 600 10px, .16em, uppercase · #2BD9C8 · panel 1px solid #1D5B57 with a 3px solid #2BD9C8 left border on --surface · 16/18px pad	Read-only explanation panel.
55	Why-this-severity note	Same as #11	plain-language reading of the scored elements · overall level n of 4.
56	Indicator tick	Mono 700 10px · #2BD9C8 · chip accent @7% · 1px solid #1D5B57 · 5/8px pad	Marks a model indicator that fired.
57	Indicator label — Dense smoke blocking vision	Sans 500 12.5px · #D5DFE8	Read-only.
58	Indicator tick	Same as #56	Marks a model indicator that fired.
59	Indicator label — Large flame wall	Same as #57	Read-only.
60	Indicator tick	Same as #56	Marks a model indicator that fired.
61	Indicator label — Embers across frame	Same as #57	Read-only.
62	Indicator tick	Same as #56	Marks a model indicator that fired.
63	Indicator label — Occupied structures in fire line	Same as #57	Read-only.
64	Severity summary	Sans 400 15px/1.55 · #D5DFE8	Crown fire with a well-developed convection column, running towards occupied dwellings on the only sealed egress.
65	Reason bullet marker	5×5px solid #2BD9C8 square	Marker for the bullet beside it.
66	Reason bullet	Sans 400 13.5px/1.55 · #A8B6C2	Flame height in image consistent with crown fire behaviour.
67	Reason bullet marker	Same as #65	Marker for the bullet beside it.
68	Reason bullet	Same as #66	Twelve dwellings within 800 m, downwind of the front.


#	Element	Visual spec	Behaviour / interaction
69	Reason bullet marker	Same as #65	Marker for the bullet beside it.
70	Reason bullet	Same as #66	Ridge Rd is the only egress and is already smoke-affected.
71	Footer — confidence	Mono 400 11px · #8B9AA8	Restates the confidence figure.
72	Footer — assessed time	Same as #71	When the assessment ran.
73	Footer — model version	Same as #71	model v0.3 — a fixed string in the prototype.
74	Footer — provenance	Same as #71	· AI-classified
75	HOW THIS SEVERITY WAS SCORED heading	Mono 600 10px, .16em, uppercase · #E6EDF3 · card 1px solid #26333F on --surface	Section label.
76	Scoring note	Same as #11	four elements scored 1–4 · summed 4–16 · mapped to one level.
77	STEP 1 marker	Mono 700 9px, .14em · #5C6B77 · tile 1px #22303C on --panel · 11/13px pad	States the pipeline order: the fire / not-fire gate runs before any scoring.
78	STEP 1 title — Fire / not fire	Mono 600 11px, .1em, uppercase · #E6EDF3	Static.
79	STEP 1 body	Sans 400 12.5px · #A8B6C2	Classified as a fire at 0.92 confidence, at or above the 0.75 threshold.
80	STEP 1 result chip — FIRE	Mono 700 9px, .12em · #5FD98C on green @9% · 1px solid #1E6B3D · 4/7px pad	Shows NOT A FIRE (#5C6B77 on --surface-3) when the gate rejects the image; a not-a-fire result is never scored.
81	STEP 2 marker	Mono 700 9px, .14em · #5C6B77	Second stage of the pipeline.
82	STEP 2 title — Severity score	Same as #78	Static.
83	STEP 2 body	Same as #79	Smoke, flame, damage and people proximity scored 1–4 and summed to 16 of 16.
84	STEP 2 result chip — SCORED	Mono 700 9px, .12em · #D5DFE8 on --surface-2 · 1px solid #26333F · 4/7px pad	States that the four element scores exist for this record.
85	Element label — Smoke level	Mono 600 11px, .08em, uppercase · #D5DFE8 · 150px column · 1px #161F28 top border	Read-only. One of four elements scored 1–4 and summed to the 4–16 total.
86	Score cell 1 (filled)	28×23px · Mono 700 10px · #7A0F16 fill · #FFFFFF numeral · 4px #FF4D4D ring · 1px ring	Filled up to the element score. Display only.
87	Score cell 2 (filled)	Same as #86	Filled up to the element score. Display only.
88	Score cell 3 (filled)	Same as #86	Filled up to the element score. Display only.
89	Score cell 4 (filled)	Same as #86	Filled up to the element score. Display only.
90	Element value — 4	Mono 700 16px · #E6EDF3	The 1–4 score for this element.
91	Element description	Sans 400 13px · #A8B6C2	Fixed rubric string: Very dense smoke, blocking vision
92	Element label — Flame visibility	Same as #85	Read-only. One of four elements scored 1–4 and summed to the 4–16 total.
93	Score cell 1 (filled)	Same as #86	Filled up to the element score. Display only.
94	Score cell 2 (filled)	Same as #86	Filled up to the element score. Display only.
95	Score cell 3 (filled)	Same as #86	Filled up to the element score. Display only.
96	Score cell 4 (filled)	Same as #86	Filled up to the element score. Display only.
97	Element value — 4	Same as #90	The 1–4 score for this element.
98	Element description	Same as #91	Fixed rubric string: Large flame wall front, embers flying

#	Element	Visual spec	Behaviour / interaction
99	Element label — Damage / impact	Same as #85	Read-only. One of four elements scored 1–4 and summed to the 4–16 total.
100	Score cell 1 (filled)	Same as #86	Filled up to the element score. Display only.
101	Score cell 2 (filled)	Same as #86	Filled up to the element score. Display only.
102	Score cell 3 (filled)	Same as #86	Filled up to the element score. Display only.
103	Score cell 4 (filled)	Same as #86	Filled up to the element score. Display only.
104	Element value — 4	Same as #90	The 1–4 score for this element.
105	Element description	Same as #91	Fixed rubric string: Extensive burnt area, vegetation and infrastructure
106	Element label — People proximity	Same as #85	Read-only. One of four elements scored 1–4 and summed to the 4–16 total.
107	Score cell 1 (filled)	Same as #86	Filled up to the element score. Display only.
108	Score cell 2 (filled)	Same as #86	Filled up to the element score. Display only.
109	Score cell 3 (filled)	Same as #86	Filled up to the element score. Display only.
110	Score cell 4 (filled)	Same as #86	Filled up to the element score. Display only.
111	Element value — 4	Same as #90	The 1–4 score for this element.
112	Element description	Same as #91	Fixed rubric string: People in direct proximity, immediate help required
113	Total score label	Mono 600 11px, .08em, uppercase · #E6EDF3 · 1px #2C3A48 top border, 13px top pad	—
114	Range note — range 4 – 16	Same as #71	States the fixed scale.
115	Total value — 16	Mono 700 20px · #E6EDF3	Sum of the four element scores.
116	Band sentence	Sans 500 13.5px · #D5DFE8	16 falls in the 14–16 band → Catastrophic.
117	Band-map dot — level 1	20px circle · Mono 700 9px · #F5C842 fill · #1A1405 numeral · 2px #FFE08A ring · 1px ring	Static reference.
118	Band-map label — 4–7 → MOD	Mono 600 10px/1.4 · #8B9AA8 · cell 1px solid #161F28	Other bands, shown for reference.
119	Band-map dot — level 2	20px circle · Mono 700 9px · #F58021 fill · #1A0C02 numeral · 2px #FFB36B ring · 1px ring	Static reference.
120	Band-map label — 8–10 → HIGH	Same as #118	Other bands, shown for reference.
121	Band-map dot — level 3	20px circle · Mono 700 9px · #E03127 fill · #FFFFFF numeral · 3px #FF8078 ring · 1px ring	Static reference.
122	Band-map label — 11–13 → EXT	Same as #118	Other bands, shown for reference.
123	Band-map dot — level 4	20px circle · Mono 700 9px · #7A0F16 fill · #FFFFFF numeral · 4px #FF4D4D ring · 1px ring	Static reference.
124	Band-map label — 14–16 → CAT	Mono 600 10px/1.4 · #E6EDF3 · cell on --tint with a 1px #2BD9C8 border	The band this incident falls in, highlighted.
125	NEARBY label	Mono 500 10px, .14em, uppercase · #8B9AA8	Labels the nearby strip.
126	NEARBY chip — INC-0431 (11.4 km)	Chip 1px solid #22303C on --panel · 6/11px pad · 20px band dot + ID Mono 600 11px #C4D0DA + distance Mono 400 11px #8B9AA8 · hover border #2BD9C8, bg --tint-2	Opens that incident detail screen.

#	Element	Visual spec	Behaviour / interaction
127	NEARBY chip — INC-0426 (18.9 km)	Same as #126	Opens that incident detail screen.
128	NEARBY chip — INC-0419 (26.5 km)	Same as #126	Opens that incident detail screen.

Figure 11 — State 2 — severity override applied (override, toast, Undo, log)

Captured immediately after pressing EXT on a Catastrophic incident. Badges 131–137 cover the toast.

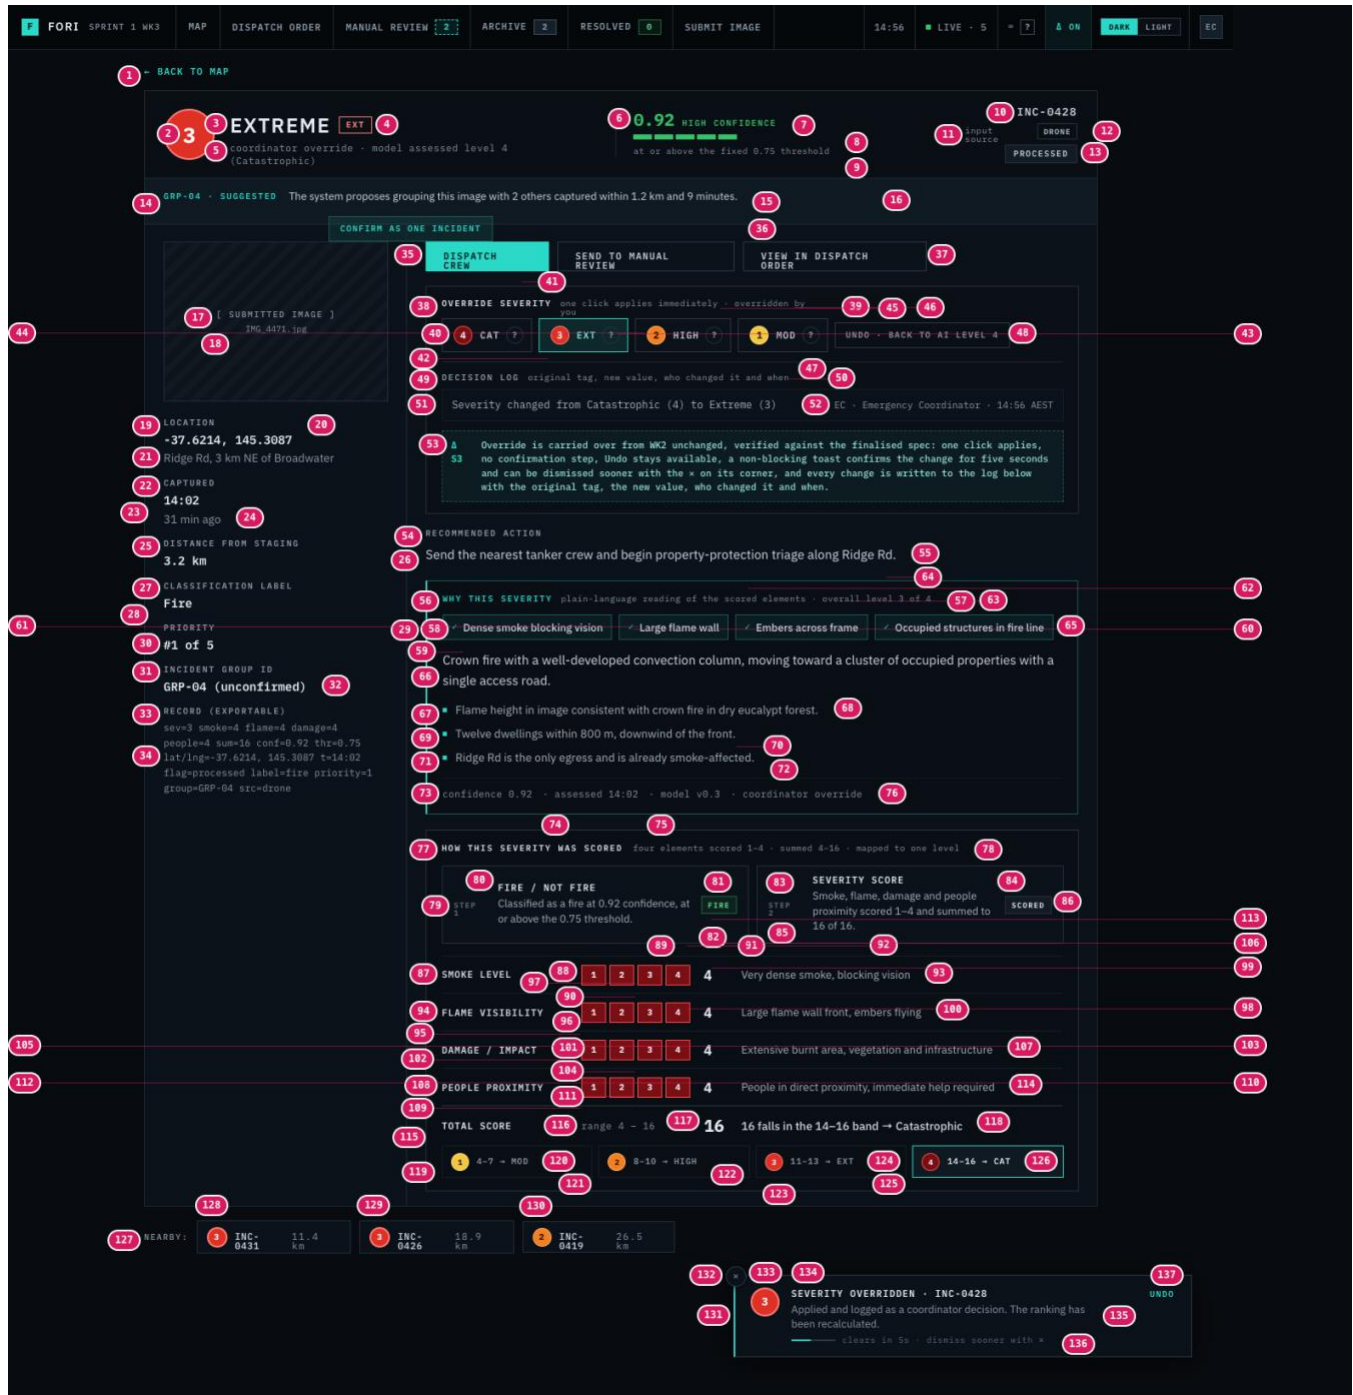

#	Element	Visual spec	Behaviour / interaction
1	← Back to map link	Mono 600 11px, .1em, uppercase · #2BD9C8 · hover #7FEFE3	Click → Map, whatever screen the user arrived from.
2	Severity numeral — 3	Mono 700 25px · #FFFFFF · inside a 64px dot (56px + 4px #FF8078 ring) with a 4px --halo outer ring	The band level 1–4, or a question mark when no severity is applied. Diameter and ring weight step with the band (26/2, 34/2, 42/3, 50/4 base).
3	Band name — Extreme	Sans 600 24px/1.1, .06em, uppercase · #E6EDF3	Derived from the applied severity.

#	Element	Visual spec	Behaviour / interaction
4	Band abbreviation chip	Mono 700 10px, .14em · #FF8078 on --halo #0A1016 · 1px solid #FF8078 · 4/7px pad	Static.
5	Provenance line	Mono 400 11px/1.4 · #8B9AA8	coordinator override · model assessed level 4 (Catastrophic) — provenance flips the moment the override lands.
6	Confidence figure — 0.92	Mono 700 20px · #35C46A	The model confidence for this image. A coordinator action never changes it.
7	Confidence label — High confidence	Mono 600 10px, .14em, uppercase · #35C46A	≥0.85 High confidence #35C46A · 0.75–0.84 Moderate #F5C842 · below 0.75 Low #2BD9C8.
8	Confidence segments	Five 22×6px segments · filled #35C46A, empty #1B2731 · 20px left pad behind a 1px --border rule	Segment count = round(confidence / 20), minimum 1.
9	Threshold note	Mono 400 10px/1.4 · #8B9AA8	at or above the fixed 0.75 threshold
10	Incident ID — INC-0428	Mono 600 13px, .08em · #C4D0DA · right-aligned	Static.
11	input source label	Mono 400 10px · #8B9AA8	Labels the channel chip.
12	Input-source chip — DRONE	Mono 700 9px, .12em · #A8B6C2 · 1px solid #26333F · 4/6px pad · tooltip gives the full channel name	The visible per-incident record of which of the four input channels the image arrived on: MANUAL / DRONE / SAT / API.
13	Status flag chip — Processed	Mono 600 10px, .12em, uppercase · #C4D0DA on --surface-2 #131C25 · 1px solid #26333F · 5/9px pad	One flag per image at a time: Processed / Flagged · review / Not a fire / Extinguished / Dispatched.
14	Grouping banner title — GRP-04 · SUGGESTED	Mono 600 10px, .14em · #2BD9C8 · full-width band on --tint with a 1px --border bottom	Shown only for images in the proposed group. The suffix follows the group state: SUGGESTED, GROUPED, KEPT SEPARATE.
15	Grouping banner sentence	Sans 400 12.5px · #D5DFE8	States the proximity and time window behind the proposal.
16	Grouping banner action — Confirm as one incident	Mono 600 10px, .12em, uppercase · #2BD9C8 on accent @10% · 1px solid #1D5B57 · 9/12px pad	One click confirms the group and logs it; the action then becomes Split into separate incidents. Nothing is auto-committed.
17	Image placeholder frame	308px column · 186px tall · 1px #22303C · 135° hatch #0E141B / #111921 at 8px	Placeholder for the incident image.
18	Image file name	Same as #11	From the submission record.
19	Field key — LOCATION	Mono 600 10px, .16em, uppercase · #8B9AA8	Read-only field label.
20	Field value — -37.6214, 145.3087	Mono 600 14px/1.3 · #E6EDF3	Read-only.
21	Field sub-line — Ridge Rd, 3 km NE of Broadwater	Sans 400 13.5px · #8B9AA8	Secondary line under the value.
22	Field key — CAPTURED	Same as #19	Read-only field label.
23	Field value — 14:02	Same as #20	Read-only.
24	Field sub-line — 31 min ago	Same as #21	Secondary line under the value.
25	Field key — DISTANCE FROM STAGING	Same as #19	Read-only field label.
26	Field value — 3.2 km	Same as #20	Read-only.
27	Field key — CLASSIFICATION LABEL	Same as #19	Read-only field label.
28	Field value — Fire	Same as #20	Resolves to Fire / Non-Fire / Extinguished / Uncertain.
29	Field key — PRIORITY	Same as #19	Read-only field label.

#	Element	Visual spec	Behaviour / interaction
30	Field value — #1 of 5	Same as #20	Resolves to #n of m, live · crew dispatched, not ranked, or resolved · not ranked.
31	Field key — INCIDENT GROUP ID	Same as #19	Read-only field label.
32	Field value — GRP-04 (unconfirmed)	Same as #20	Resolves to GRP-04, GRP-04 (unconfirmed), or none.
33	RECORD (EXPORTABLE) key	Same as #19	Labels the flat record dump.
34	Exportable record	Mono 400 11px/1.6 · #8B9AA8	sev=3 ... conf=0.92 thr=0.75 — the override rewrites sev only; the confidence and the model element scores are untouched on an override of an AI-classified incident.
35	Dispatch crew primary button	Mono 600 11px, .12em, uppercase · #04191A on #2BD9C8 · 1px solid #2BD9C8 · 11/20px pad · hover #7FEFE3 · active #17A093	Assigns a crew: the incident moves to LIVE / DISPATCHED in the dispatch order, the flag becomes Dispatched, the button relabels to Crew dispatched ✓, and Mark extinguished and Cancel dispatch appear. Toast: Tanker 12 en route.
36	Send to manual review button	Mono 600 11px, .12em, uppercase · #C4D0DA · 1px solid #2C3A48 · 11/20px pad · hover bg --surface-2	Withdraws the applied tag, removes the incident from the ranking and the map, adds it to the review queue marked sent by coordinator, logs it and navigates to Manual Review.
37	View in dispatch order button	Same as #36	Click → Dispatch Order.
38	OVERRIDE SEVERITY heading	Mono 600 10px, .16em, uppercase · #E6EDF3 · card 1px solid #26333F on --map-bg · 15/18px pad	Section label.
39	Override state note	Same as #11	one click applies immediately · overridden by you
40	Override chip CAT	Chip --panel · 1px solid #2C3A48 · 20px dot (#7A0F16 fill · #FFFFFF numeral · 4px #FF4D4D ring, 2px ring) · label Mono 600 11px, .1em, uppercase #C4D0DA · current level: bg accent @12%, 1px #2BD9C8, label #7FEFE3	One click applies severity 4 immediately — no confirmation dialog and no save step. The ranking, the map marker and the dispatch order recalculate, an Undo appears, and the change is written to the decision log with the original value, the new value, who and when.
41	Band explainer ? — CAT	19px circle · Mono 700 10px · #8B9AA8 · 1px solid #26333F · hover border and text #2BD9C8, bg accent @10%	Toggles the inline rubric panel for that band. Does not change the severity.
42	Override chip EXT	Chip --panel · 1px solid #2C3A48 · 20px dot (#E03127 fill · #FFFFFF numeral · 3px #FF8078 ring, 2px ring) · label Mono 600 11px, .1em, uppercase #C4D0DA · current level: bg accent @12%, 1px #2BD9C8, label #7FEFE3	One click applies severity 3 immediately — no confirmation dialog and no save step. The ranking, the map marker and the dispatch order recalculate, an Undo appears, and the change is written to the decision log with the original value, the new value, who and when.
43	Band explainer ? — EXT	Same as #41	Toggles the inline rubric panel for that band. Does not change the severity.
44	Override chip HIGH	Chip --panel · 1px solid #2C3A48 · 20px dot (#F58021 fill · #1A0C02 numeral · 2px #FFB36B ring, 2px ring) · label Mono 600 11px, .1em, uppercase #C4D0DA · current level: bg accent @12%, 1px #2BD9C8, label #7FEFE3	One click applies severity 2 immediately — no confirmation dialog and no save step. The ranking, the map marker and the dispatch order recalculate, an Undo appears, and the change is written to the decision log with the original value, the new value, who and when.
45	Band explainer ? — HIGH	Same as #41	Toggles the inline rubric panel for that band. Does not change the severity.
46	Override chip MOD	Chip --panel · 1px solid #2C3A48 · 20px dot (#F5C842 fill · #1A1405 numeral · 2px #FFE08A ring, 2px ring) ·	One click applies severity 1 immediately — no confirmation dialog and no save step. The ranking,

#	Element	Visual spec	Behaviour / interaction
		label Mono 600 11px, .1em, uppercase #C4D0DA · current level: bg accent @12%, 1px #2BD9C8, label #7FEFE3	the map marker and the dispatch order recalculate, an Undo appears, and the change is written to the decision log with the original value, the new value, who and when.
47	Band explainer ? — MOD	Same as #41	Toggles the inline rubric panel for that band. Does not change the severity.
48	Inline Undo — back to AI level 4	Mono 600 10px, .12em, uppercase · #8B9AA8 · 1px solid #2C3A48 · 9/12px pad · hover text --fg, border #42525F	Reverts to the model value and logs Reverted to the AI assessment (undo). Present only while a plain override is in force — it does not appear after a Confirm or a manual assignment, which are undoable only inside the 5-second toast.
49	DECISION LOG heading	Mono 600 10px, .16em, uppercase · #8B9AA8 · 1px --border top rule, 13px top pad	Per-incident log only. There is no cross-incident audit view in the build.
50	Decision-log note	Same as #11	original tag, new value, who changed it and when — states the shape of each entry.
51	Log entry — override	Mono 400 12px/1.5 · #A8B6C2 · row 1px #161F28 on -panel · 9/11px pad	Severity changed from Catastrophic (4) to Extreme (3) — original value, new value, who and when, as specified.
52	Log entry who / when	Mono 400 11px · #8B9AA8 · right-aligned	EC · Emergency Coordinator · 14:56 AEST
53	Δ S3 change note	Mono 500 11px/1.5 · #9FE9E0 on accent @6% · 1px dashed #1D5B57 · Δ S3 marker Mono 700 11px #2BD9C8	Prototype commentary, not product UI. Toggled by the header Δ ON/OFF control.
54	RECOMMENDED ACTION heading	Same as #19	Section label.
55	Recommended action text	Sans 400 15px/1.5 · #D5DFE8	Send the nearest tanker crew and begin property protection on Ridge Rd.
56	WHY THIS SEVERITY heading	Mono 600 10px, .16em, uppercase · #2BD9C8 · panel 1px solid #1D5B57 with a 3px solid #2BD9C8 left border on --surface · 16/18px pad	Read-only explanation panel.
57	Why-this-severity note	Same as #11	plain-language reading of the scored elements · overall level n of 4.
58	Indicator tick	Mono 700 10px · #2BD9C8 · chip accent @7% · 1px solid #1D5B57 · 5/8px pad	Marks a model indicator that fired.
59	Indicator label — Dense smoke blocking vision	Sans 500 12.5px · #D5DFE8	Read-only.
60	Indicator tick	Same as #58	Marks a model indicator that fired.
61	Indicator label — Large flame wall	Same as #59	Read-only.
62	Indicator tick	Same as #58	Marks a model indicator that fired.
63	Indicator label — Embers across frame	Same as #59	Read-only.
64	Indicator tick	Same as #58	Marks a model indicator that fired.
65	Indicator label — Occupied structures in fire line	Same as #59	Read-only.
66	Severity summary	Sans 400 15px/1.55 · #D5DFE8	Crown fire with a well-developed convection column, running towards occupied dwellings on the only sealed egress.
67	Reason bullet marker	5x5px solid #2BD9C8 square	Marker for the bullet beside it.

#	Element	Visual spec	Behaviour / interaction
68	Reason bullet	Sans 400 13.5px/1.55 · #A8B6C2	Flame height in image consistent with crown fire behaviour.
69	Reason bullet marker	Same as #67	Marker for the bullet beside it.
70	Reason bullet	Same as #68	Twelve dwellings within 800 m, downwind of the front.
71	Reason bullet marker	Same as #67	Marker for the bullet beside it.
72	Reason bullet	Same as #68	Ridge Rd is the only egress and is already smoke-affected.
73	Footer — confidence	Mono 400 11px · #8B9AA8	Restates the confidence figure.
74	Footer — assessed time	Same as #73	When the assessment ran.
75	Footer — model version	Same as #73	model v0.3 — a fixed string in the prototype.
76	Footer — provenance	Same as #73	· coordinator override
77	HOW THIS SEVERITY WAS SCORED heading	Mono 600 10px, .16em, uppercase · #E6EDF3 · card 1px solid #26333F on --surface	Section label.
78	Scoring note	Same as #11	four elements scored 1–4 · summed 4–16 · mapped to one level.
79	STEP 1 marker	Mono 700 9px, .14em · #5C6B77 · tile 1px #22303C on --panel · 11/13px pad	States the pipeline order: the fire / not-fire gate runs before any scoring.
80	STEP 1 title — Fire / not fire	Mono 600 11px, .1em, uppercase · #E6EDF3	Static.
81	STEP 1 body	Sans 400 12.5px · #A8B6C2	Classified as a fire at 0.92 confidence, at or above the 0.75 threshold.
82	STEP 1 result chip — FIRE	Mono 700 9px, .12em · #5FD98C on green @9% · 1px solid #1E6B3D · 4/7px pad	Shows NOT A FIRE (#5C6B77 on --surface-3) when the gate rejects the image; a not-a-fire result is never scored.
83	STEP 2 marker	Mono 700 9px, .14em · #5C6B77	Second stage of the pipeline.
84	STEP 2 title — Severity score	Same as #80	Static.
85	STEP 2 body	Same as #81	Smoke, flame, damage and people proximity scored 1–4 and summed to 16 of 16.
86	STEP 2 result chip — SCORED	Mono 700 9px, .12em · #D5DFE8 on --surface-2 · 1px solid #26333F · 4/7px pad	The model scores remain on the record after an override of an AI-classified incident.
87	Element label — Smoke level	Mono 600 11px, .08em, uppercase · #D5DFE8 · 150px column · 1px #161F28 top border	Read-only. One of four elements scored 1–4 and summed to the 4–16 total.
88	Score cell 1 (filled)	28×23px · Mono 700 10px · #7A0F16 fill · #FFFFFF numeral · 4px #FF4D4D ring · 1px ring	Filled up to the element score. Display only.
89	Score cell 2 (filled)	Same as #88	Filled up to the element score. Display only.
90	Score cell 3 (filled)	Same as #88	Filled up to the element score. Display only.
91	Score cell 4 (filled)	Same as #88	Filled up to the element score. Display only.
92	Element value — 4	Mono 700 16px · #E6EDF3	The 1–4 score for this element.
93	Element description	Sans 400 13px · #A8B6C2	Fixed rubric string: Very dense smoke, blocking vision
94	Element label — Flame visibility	Same as #87	Read-only. One of four elements scored 1–4 and summed to the 4–16 total.
95	Score cell 1 (filled)	Same as #88	Filled up to the element score. Display only.
96	Score cell 2 (filled)	Same as #88	Filled up to the element score. Display only.

#	Element	Visual spec	Behaviour / interaction
97	Score cell 3 (filled)	Same as #88	Filled up to the element score. Display only.
98	Score cell 4 (filled)	Same as #88	Filled up to the element score. Display only.
99	Element value — 4	Same as #92	The 1–4 score for this element.
100	Element description	Same as #93	Fixed rubric string: Large flame wall front, embers flying
101	Element label — Damage / impact	Same as #87	Read-only. One of four elements scored 1–4 and summed to the 4–16 total.
102	Score cell 1 (filled)	Same as #88	Filled up to the element score. Display only.
103	Score cell 2 (filled)	Same as #88	Filled up to the element score. Display only.
104	Score cell 3 (filled)	Same as #88	Filled up to the element score. Display only.
105	Score cell 4 (filled)	Same as #88	Filled up to the element score. Display only.
106	Element value — 4	Same as #92	The 1–4 score for this element.
107	Element description	Same as #93	Fixed rubric string: Extensive burnt area, vegetation and infrastructure
108	Element label — People proximity	Same as #87	Read-only. One of four elements scored 1–4 and summed to the 4–16 total.
109	Score cell 1 (filled)	Same as #88	Filled up to the element score. Display only.
110	Score cell 2 (filled)	Same as #88	Filled up to the element score. Display only.
111	Score cell 3 (filled)	Same as #88	Filled up to the element score. Display only.
112	Score cell 4 (filled)	Same as #88	Filled up to the element score. Display only.
113	Element value — 4	Same as #92	The 1–4 score for this element.
114	Element description	Same as #93	Fixed rubric string: People in direct proximity, immediate help required
115	Total score label	Mono 600 11px, .08em, uppercase · #E6EDF3 · 1px #2C3A48 top border, 13px top pad	—
116	Range note — range 4 – 16	Same as #73	States the fixed scale.
117	Total value — 16	Mono 700 20px · #E6EDF3	Sum of the four element scores.
118	Band sentence	Sans 500 13.5px · #D5DFE8	16 falls in the 14–16 band → Catastrophic. Note the scoring block still reports the model total of 16 while the applied severity reads Extreme (3): the two are deliberately not reconciled.
119	Band-map dot — level 1	20px circle · Mono 700 9px · #F5C842 fill · #1A1405 numeral · 2px #FFE08A ring · 1px ring	Static reference.
120	Band-map label — 4–7 → MOD	Mono 600 10px/1.4 · #8B9AA8 · cell 1px solid #161F28	Other bands, shown for reference.
121	Band-map dot — level 2	20px circle · Mono 700 9px · #F58021 fill · #1A0C02 numeral · 2px #FFB36B ring · 1px ring	Static reference.
122	Band-map label — 8–10 → HIGH	Same as #120	Other bands, shown for reference.
123	Band-map dot — level 3	20px circle · Mono 700 9px · #E03127 fill · #FFFFFF numeral · 3px #FF8078 ring · 1px ring	Static reference.
124	Band-map label — 11–13 → EXT	Same as #120	Other bands, shown for reference.
125	Band-map dot — level 4	20px circle · Mono 700 9px · #7A0F16 fill · #FFFFFF	Static reference.


#	Element	Visual spec	Behaviour / interaction
		numeral · 4px #FF4D4D ring · 1px ring	
126	Band-map label — 14–16 → CAT	Mono 600 10px/1.4 · #E6EDF3 · cell on --tint with a 1px #2BD9C8 border	The band this incident falls in, highlighted.
127	NEARBY label	Mono 500 10px, .14em, uppercase · #8B9AA8	Labels the nearby strip.
128	NEARBY chip — INC-0431 (11.4 km)	Chip 1px solid #22303C on --panel · 6/11px pad · 20px band dot + ID Mono 600 11px #C4D0DA + distance Mono 400 11px #8B9AA8 · hover border #2BD9C8, bg --tint-2	Opens that incident detail screen.
129	NEARBY chip — INC-0426 (18.9 km)	Same as #128	Opens that incident detail screen.
130	NEARBY chip — INC-0419 (26.5 km)	Same as #128	Opens that incident detail screen.
131	Toast container	Max-width 460–500px · --panel #0C1219 · 1px solid #2C3A48 · 3px left border #2BD9C8 · 14/18px pad · shadow 0 8px 30px rgba(0,0,0,.6)	In the running app the toast is fixed at top 64px / right 20px and is non-blocking; it is shown at the foot of this figure so it does not cover the screen. Auto-clears after 5 seconds.
132	Toast dismiss ×	23px circle offset –11px/–11px outside the top-left corner · --panel · 1px solid #2C3A48 · Mono 400 11px #8B9AA8	Cancels the 5s timer and removes the toast immediately.
133	Toast icon	36px circle · Mono 700 13px · #E03127 fill · #FFFFFF numeral · 3px #FF8078 ring	Shows the new value.
134	Toast title — Severity overridden · INC-0428	Same as #80	Names the action and the affected id.
135	Toast body	Sans 400 12.5px · #8B9AA8	Applied and logged as a coordinator decision. The ranking has been recalculated.
136	Auto-clear indicator	52×2px track #2C3A48 with a #2BD9C8 fill animating scaleX(1→0) over 5s linear · caption Mono 400 10px #5C6B77	Visible countdown of the 5s timer: clears in 5s, dismiss sooner with ×.
137	Toast Undo	Mono 600 10px, .12em, uppercase · #2BD9C8 · hover #7FEFE3	Same revert as the inline Undo, available for the 5 seconds the toast is visible.

Map

Map canvas (1fr) plus a 372 px right rail. The canvas is a synthetic terrain with a sector bar top-left, a severity legend bottom-left and zoom controls top-right; markers are deconflicted against each other, the fixed place labels and the legend at every zoom. Three states are documented: the default zoom, the clustered zoom, and the Alerts & Suggested rail, which carries the incident-grouping propose / confirm / split interaction.

Figure 12 — State 1 — default view (Z2 "DISTRICT")

The app opens here. Note that no cluster is drawn at this zoom with the built dataset — see badge 42 and Open items.

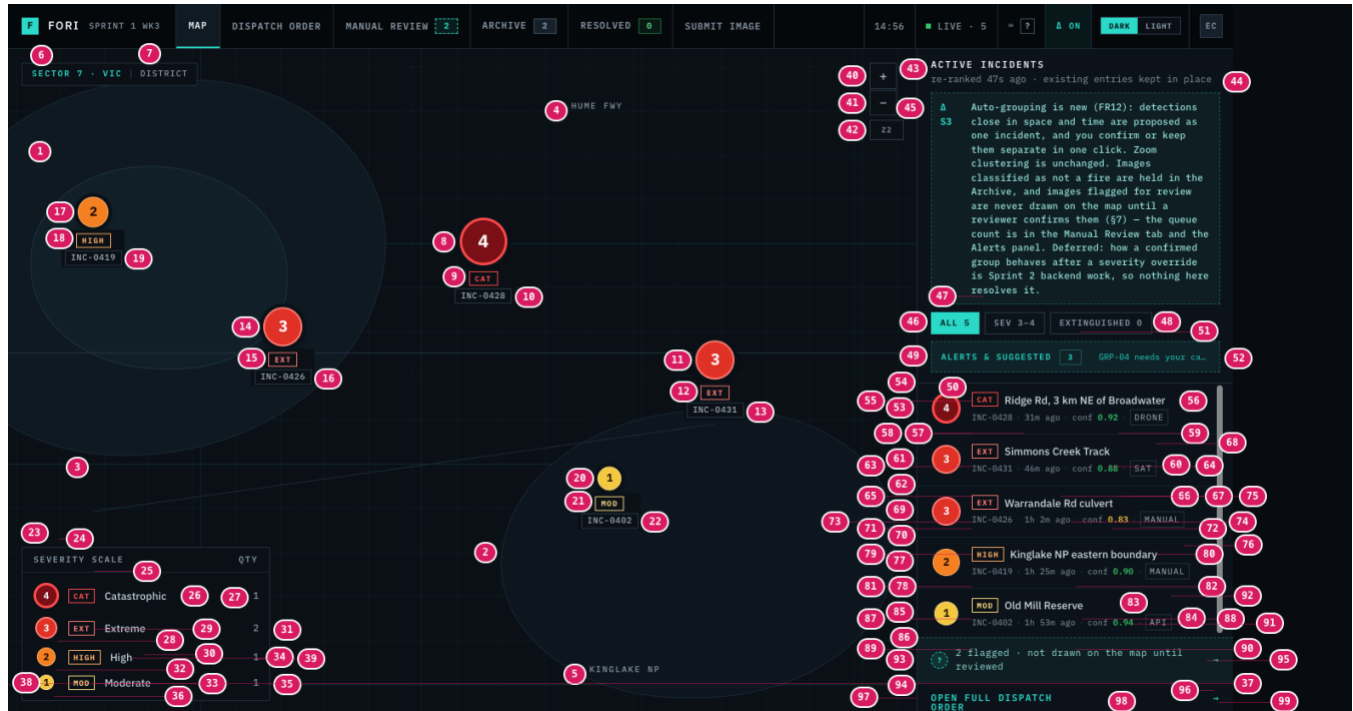

#	Element	Visual spec	Behaviour / interaction
1	Terrain shape 1	Organic blob · --ter-1 #0E1922 fill · 1px solid #1B2A33	Non-interactive backdrop. A stylised stand-in for a real basemap, not geographic data.
2	Terrain shape 2	--ter-2 #112028 fill · 1px solid #1E323B	Non-interactive.
3	Contour band	--ter-line-2 #1E2C38 · 731×104px	Non-interactive. Two grid layers sit behind it at 48px (accent @5.5%) and 240px (accent @9%), scaled by transform scale(1 + (zoom-1) × 0.08) over .25s.
4	Place label — HUME FWY	Mono 500 10px, .16em · #8B9AA8 · pointer-events none	Fixed obstacle in the marker deconfliction pass: markers are pushed away from it.
5	Place label — KINGLAKE NP	Mono 500 10px, .16em · #8B9AA8	As #4.
6	Sector label — SECTOR 7 · VIC	Mono 600 10px, .16em · #2BD9C8 · bar on --halo, 1px solid #22303C, 7/11px pad	Static. SECTOR 7 · VIC is a fixed string.
7	Zoom name — DISTRICT	Mono 500 10px, .1em · #8B9AA8 · behind a 1px divider	Z1 REGIONAL · CLUSTERED, Z2 DISTRICT, Z3 SITE · ALL MARKERS.
8	Marker dot — INC-0428 (level 4)	58px overall (50px dot + 4px #FF4D4D ring) · #7A0F16 fill · #FFFFFF numeral · 4px #FF4D4D ring · Mono 700 21px numeral · 4px --halo ring · shadow 0 3px 10px rgba(0,0,0,.6) · hover scale 1.14 · focus 2px accent outline	Colour and numeral always agree: the numeral is the band level and the fill is that band colour. Click opens Incident Detail. A newly inserted marker runs pulseRing 1.6s ×3. Flagged images are never drawn.
9	Marker abbreviation chip — CAT	Mono 700 9px, .14em · #FF4D4D on --halo · 1px solid #FF4D4D · 2px halo outline	Read-only label.

#	Element	Visual spec	Behaviour / interaction
10	Marker ID chip — INC-0428	Mono 500 10px · #A8B6C2 on --halo · 1px solid #2C3A48	Read-only label.
11	Marker dot — INC-0431 (level 3)	48px overall (42px + 3px #FF8078 ring) · #E03127 fill · #FFFFFF numeral · 3px #FF8078 ring · Mono 700 18px numeral · 4px --halo ring · shadow 0 3px 10px rgba(0,0,0,.6) · hover scale 1.14 · focus 2px accent outline	Colour and numeral always agree: the numeral is the band level and the fill is that band colour. Click opens Incident Detail. A newly inserted marker runs pulseRing 1.6s ×3. Flagged images are never drawn.
12	Marker abbreviation chip — EXT	Mono 700 9px, .14em · #FF8078 on --halo · 1px solid #FF8078 · 2px halo outline	Read-only label.
13	Marker ID chip — INC-0431	Same as #10	Read-only label.
14	Marker dot — INC-0426 (level 3)	Same as #11	Colour and numeral always agree: the numeral is the band level and the fill is that band colour. Click opens Incident Detail. A newly inserted marker runs pulseRing 1.6s ×3. Flagged images are never drawn.
15	Marker abbreviation chip — EXT	Same as #12	Read-only label.
16	Marker ID chip — INC-0426	Same as #10	Read-only label.
17	Marker dot — INC-0419 (level 2)	37px overall (34px + 2px #FFB36B ring) · #F58021 fill · #1A0C02 numeral · 2px #FFB36B ring · Mono 700 15px numeral · 4px --halo ring · shadow 0 3px 10px rgba(0,0,0,.6) · hover scale 1.14 · focus 2px accent outline	Colour and numeral always agree: the numeral is the band level and the fill is that band colour. Click opens Incident Detail. A newly inserted marker runs pulseRing 1.6s ×3. Flagged images are never drawn.
18	Marker abbreviation chip — HIGH	Mono 700 9px, .14em · #FFB36B on --halo · 1px solid #FFB36B · 2px halo outline	Read-only label.
19	Marker ID chip — INC-0419	Same as #10	Read-only label.
20	Marker dot — INC-0402 (level 1)	29px overall (26px + 2px #FFE08A ring) · #F5C842 fill · #1A1405 numeral · 2px #FFE08A ring · Mono 700 12px numeral · 4px --halo ring · shadow 0 3px 10px rgba(0,0,0,.6) · hover scale 1.14 · focus 2px accent outline	Colour and numeral always agree: the numeral is the band level and the fill is that band colour. Click opens Incident Detail. A newly inserted marker runs pulseRing 1.6s ×3. Flagged images are never drawn.
21	Marker abbreviation chip — MOD	Mono 700 9px, .14em · #FFE08A on --halo · 1px solid #FFE08A · 2px halo outline	Read-only label.
22	Marker ID chip — INC-0402	Same as #10	Read-only label.
23	Legend header — SEVERITY SCALE / QTY	Mono 600 10px, .16em · #8B9AA8 · 290px panel on --halo, 1px solid #22303C, 1px #1B2731 divider	The key to the marker colour and numeral pairing.
24	Legend dot — level 4	30px circle · Mono 700 11px · #7A0F16 fill · #FFFFFF numeral · 4px #FF4D4D ring	Repeats the marker treatment at legend scale.
25	Legend chip — CAT	Mono 700 9px, .14em · #FF4D4D on --halo · 1px solid #FF4D4D	Static.
26	Legend band name — Catastrophic	Sans 500 12.5px · #C4D0DA	Static.
27	Legend count — 1	Mono 500 11px · #8B9AA8 · right-aligned	Live count over the currently active incidents.
28	Legend dot — level 3	26px circle · Mono 700 11px · #E03127 fill · #FFFFFF numeral · 3px #FF8078 ring	Repeats the marker treatment at legend scale.
29	Legend chip — EXT	Mono 700 9px, .14em · #FF8078 on --halo · 1px solid #FF8078	Static.
30	Legend band name — Extreme	Same as #26	Static.


#	Element	Visual spec	Behaviour / interaction
31	Legend count — 2	Same as #27	Live count over the currently active incidents.
32	Legend dot — level 2	22px circle · Mono 700 11px · #F58021 fill · #1A0C02 numeral · 2px #FFB36B ring	Repeats the marker treatment at legend scale.
33	Legend chip — HIGH	Mono 700 9px, .14em · #FFB36B on --halo · 1px solid #FFB36B	Static.
34	Legend band name — High	Same as #26	Static.
35	Legend count — 1	Same as #27	Live count over the currently active incidents.
36	Legend dot — level 1	18px circle · Mono 700 11px · #F5C842 fill · #1A1405 numeral · 2px #FFE08A ring	Repeats the marker treatment at legend scale.
37	Legend chip — MOD	Mono 700 9px, .14em · #FFE08A on --halo · 1px solid #FFE08A	Static.
38	Legend band name — Moderate	Same as #26	Static.
39	Legend count — 1	Same as #27	Live count over the currently active incidents.
40	Zoom in +	30×30px · Mono 500 15px #A8B6C2 on --halo · 1px solid #2C3A48 · hover bg --surface-3, text #2BD9C8	Steps zoom 1→3. Zoom changes marker spread (×1, ×1.16, ×2.05) and re-runs deconfliction.
41	Zoom out –	As the + control	Steps zoom down to 1. No-op at Z1.
42	Zoom readout — Z2	39×23px · Mono 600 9px, .08em · #8B9AA8 on --halo · 1px solid #2C3A48	Clustering is defined only for Z1 and Z2, and a cluster draws only when two or more members are visible. At Z2 the one defined cluster pairs INC-0428 with INC-0435, which is flagged and never drawn — so the default view shows no clustering at all (see Open items).
43	Rail heading — Active Incidents	Mono 600 11px, .16em, uppercase · #E6EDF3 · 372px rail	Static.
44	Rail sub-line — re-ranked 47s ago	Mono 400 11px · #8B9AA8	Ticks with the clock; states that existing entries are kept in place.
45	Δ S3 change note	Mono 500 11px/1.5 · #9FE9E0 on accent @6% · 1px dashed #1D5B57 · Δ S3 marker Mono 700 11px #2BD9C8	Prototype commentary, not product UI. Toggled by the header Δ ON/OFF control.
46	Filter — All 5	Mono 600 10px, .1em, uppercase · #04191A on #2BD9C8 · 1px solid #2BD9C8 · 7/10px pad	Selected state. Filters both the markers and the ranked list.
47	Filter — Sev 3–4	Mono 600 10px, .1em, uppercase · #8B9AA8 · transparent · 1px solid #2C3A48 · hover border #2BD9C8	Restricts to Extreme and Catastrophic.
48	Filter — Extinguished 0	As Sev 3–4	The only way to see resolved incidents on the map; they draw at 45% opacity with a 2px dashed #42525F ring and an OUT chip.
49	Alerts & Suggested toggle	Accent @8% bg · 1px dashed #1D5B57 · #2BD9C8 · 9/11px pad · pressed: solid #2BD9C8 with #04191A text	Swaps the rail between the incident list and the alerts/suggestions panel. The incident list is hidden while the panel is open.
50	Toggle label — Alerts & Suggested	Mono 600 10px, .16em · #2BD9C8	Static.
51	Toggle count chip — 3	Mono 700 9px · #2BD9C8 · 1px solid #1D5B57	Number of open alerts and suggestions.
52	Toggle note — GRP-04 needs your call	Mono 400 10px · #2BD9C8	Names the outstanding decision.
53	Ranked row — INC-0428	361×60px · grid 36px / 1fr · 11/16px pad · 1px #161F28 divider · hover bg --surface-2 · newly	Click opens Incident Detail. Rows are ordered severity first, then distance from staging; existing rows are

#	Element	Visual spec	Behaviour / interaction
		inserted row bg --tint	never reordered out from under the user on insert.
54	Row severity dot — level 4	Max 30–38px · #7A0F16 fill · #FFFFFF numeral · 4px #FF4D4D ring	Same pairing as the map marker.
55	Row abbreviation chip — CAT	Same as #25	Static.
56	Row place — Ridge Rd, 3 km NE of Broadwater	Sans 500 12.5px · #D5DFE8	Static.
57	Row incident ID — INC-0428	Mono 400 10px · #8B9AA8	Static.
58	Row age — 31m ago	Same as #57	Advances with the clock.
59	Row confidence — conf 0.92	Mono 400 10px · #8B9AA8 (figure in the confidence colour)	The model confidence against the fixed 0.75 threshold.
60	Row source chip — DRONE	Mono 400 10px · #A8B6C2 · 1px solid #26333F	The input channel this image arrived on.
61	Ranked row — INC-0431	Same as #53	Click opens Incident Detail. Rows are ordered severity first, then distance from staging; existing rows are never reordered out from under the user on insert.
62	Row severity dot — level 3	Max 30–38px · #E03127 fill · #FFFFFF numeral · 3px #FF8078 ring	Same pairing as the map marker.
63	Row abbreviation chip — EXT	Same as #29	Static.
64	Row place — Simmons Creek Track	Same as #56	Static.
65	Row incident ID — INC-0431	Same as #57	Static.
66	Row age — 46m ago	Same as #57	Advances with the clock.
67	Row confidence — conf 0.88	Same as #59	The model confidence against the fixed 0.75 threshold.
68	Row source chip — SAT	Same as #60	The input channel this image arrived on.
69	Ranked row — INC-0426	Same as #53	Click opens Incident Detail. Rows are ordered severity first, then distance from staging; existing rows are never reordered out from under the user on insert.
70	Row severity dot — level 3	Same as #62	Same pairing as the map marker.
71	Row abbreviation chip — EXT	Same as #29	Static.
72	Row place — Warrandale Rd culvert	Same as #56	Static.
73	Row incident ID — INC-0426	Same as #57	Static.
74	Row age — 1h 2m ago	Same as #57	Advances with the clock.
75	Row confidence — conf 0.83	Same as #59	The model confidence against the fixed 0.75 threshold.
76	Row source chip — MANUAL	Same as #60	The input channel this image arrived on.
77	Ranked row — INC-0419	Same as #53	Click opens Incident Detail. Rows are ordered severity first, then distance from staging; existing rows are never reordered out from under the user on insert.
78	Row severity dot — level 2	Max 30–38px · #F58021 fill · #1A0C02 numeral · 2px #FFB36B ring	Same pairing as the map marker.
79	Row abbreviation chip — HIGH	Same as #33	Static.
80	Row place — Kinglake NP eastern boundary	Same as #56	Static.

#	Element	Visual spec	Behaviour / interaction
81	Row incident ID — INC-0419	Same as #57	Static.
82	Row age — 1h 25m ago	Same as #57	Advances with the clock.
83	Row confidence — conf 0.90	Same as #59	The model confidence against the fixed 0.75 threshold.
84	Row source chip — MANUAL	Same as #60	The input channel this image arrived on.
85	Ranked row — INC-0402	Same as #53	Click opens Incident Detail. Rows are ordered severity first, then distance from staging; existing rows are never reordered out from under the user on insert.
86	Row severity dot — level 1	Max 30–38px · #F5C842 fill · #1A1405 numeral · 2px #FFE08A ring	Same pairing as the map marker.
87	Row abbreviation chip — MOD	Same as #37	Static.
88	Row place — Old Mill Reserve	Same as #56	Static.
89	Row incident ID — INC-0402	Same as #57	Static.
90	Row age — 1h 53m ago	Same as #57	Advances with the clock.
91	Row confidence — conf 0.94	Same as #59	The model confidence against the fixed 0.75 threshold.
92	Row source chip — API	Same as #60	The input channel this image arrived on.
93	Flagged-queue strip	Accent @6% bg · 1px dashed #1D5B57 top border · 10/16px pad	Click → Manual Review. The only on-map indication that flagged images exist.
94	Flagged strip badge	21px circle · accent @10% · 2px dashed #2BD9C8 · Mono 700 9px question mark	Static marker.
95	Flagged strip text	Mono 400 11px · #9FE9E0	2 flagged · not drawn on the map until reviewed.
96	Flagged strip arrow →	Mono 600 10px · #2BD9C8	Affordance for the click target.
97	Open full dispatch order (row)	Mono 600 11px, .12em, uppercase · #2BD9C8 · 13/16px pad · 1px --border top · hover bg --tint-2	Click → Dispatch Order.
98	Open full dispatch order label	Mono 600 11px, .12em, uppercase · #2BD9C8	Static.
99	Open full dispatch order arrow →	Mono 600 11px · #2BD9C8	Static.

Figure 13 — State 2 — clustered view (Z1 "REGIONAL · CLUSTERED")

Reached with the – control. Two clusters of two are drawn; INC-0428 stays an individual marker because its cluster has only one visible member.

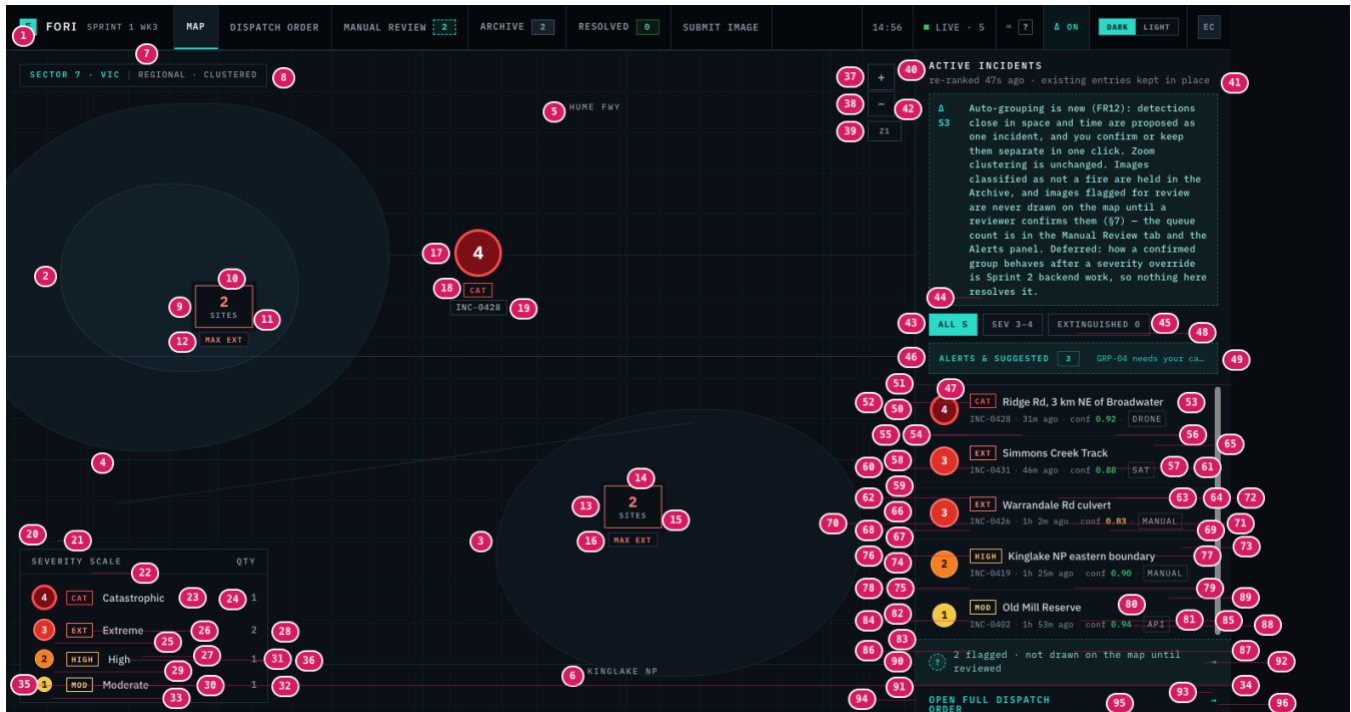

#	Element	Visual spec	Behaviour / interaction
1	Map canvas	1059×781px · --map-bg #0A1016	The whole map surface; markers are positioned inside it and deconflicted against each other, the place labels and the legend on every zoom.
2	Terrain shape 1	Organic blob · --ter-1 #0E1922 fill · 1px solid #1B2A33	Non-interactive backdrop. A stylised stand-in for a real basemap, not geographic data.
3	Terrain shape 2	--ter-2 #112028 fill · 1px solid #1E323B	Non-interactive.
4	Contour band	--ter-line-2 #1E2C38 · 731×104px	Non-interactive. Two grid layers sit behind it at 48px (accent @5.5%) and 240px (accent @9%), scaled by transform scale(1 + (zoom-1) × 0.08) over .25s.
5	Place label — HUME FWY	Mono 500 10px, .16em · #8B9AA8 · pointer-events none	Fixed obstacle in the marker deconfliction pass: markers are pushed away from it.
6	Place label — KINGLAKE NP	Mono 500 10px, .16em · #8B9AA8	As #4.
7	Sector label — SECTOR 7 · VIC	Mono 600 10px, .16em · #2BD9C8 · bar on --halo, 1px solid #22303C, 7/11px pad	Static. SECTOR 7 · VIC is a fixed string.
8	Zoom name — REGIONAL · CLUSTERED	Mono 500 10px, .1em · #8B9AA8 · behind a 1px divider	Z1 REGIONAL · CLUSTERED, Z2 DISTRICT, Z3 SITE · ALL MARKERS.
9	Cluster badge	69×51px square (min 40px + 4px per member) · --map-bg · 2px solid #FF8078 (the highest member band ring) · 0 0 0 4px --halo · shadow 0 3px 12px · hover scale 1.08	Click zooms in one step (max Z3), which expands the cluster into individual markers. Tooltip: 2 sites in this area · highest severity Extreme · click to expand. Clusters are squares; individual markers are circles.
10	Cluster count — 2	Mono 700 17px · #FF8078	Number of member incidents currently visible.
11	Cluster SITES label	Mono 600 9px, .12em · #8B9AA8	Static.
12	Cluster max-severity label — MAX EXT	Mono 600 9px, .1em · #FF8078 on --halo · 1px solid #2C3A48 · 3/6px pad	Reports the worst severity inside the cluster. A · ? suffix is appended when a member is flagged.
13	Cluster badge	Same as #9	Click zooms in one step (max Z3), which expands the

#	Element	Visual spec	Behaviour / interaction
			cluster into individual markers. Tooltip: 2 sites in this area · highest severity Extreme · click to expand. Clusters are squares; individual markers are circles.
14	Cluster count — 2	Same as #10	Number of member incidents currently visible.
15	Cluster SITES label	Same as #11	Static.
16	Cluster max-severity label — MAX EXT	Same as #12	Reports the worst severity inside the cluster. A · ? suffix is appended when a member is flagged.
17	Marker dot — INC-0428 (level 4)	58px overall (50px dot + 4px #FF4D4D ring) · #7A0F16 fill · #FFFFFF numeral · 4px #FF4D4D ring · Mono 700 21px numeral · 4px --halo ring · shadow 0 3px 10px rgba(0,0,0,.6) · hover scale 1.14 · focus 2px accent outline	Colour and numeral always agree: the numeral is the band level and the fill is that band colour. Click opens Incident Detail. A newly inserted marker runs pulseRing 1.6s ×3. Flagged images are never drawn.
18	Marker abbreviation chip — CAT	Mono 700 9px, .14em · #FF4D4D on --halo · 1px solid #FF4D4D · 2px halo outline	Read-only label.
19	Marker ID chip — INC-0428	Mono 500 10px · #A8B6C2 on --halo · 1px solid #2C3A48	Read-only label.
20	Legend header — SEVERITY SCALE / QTY	Mono 600 10px, .16em · #8B9AA8 · 290px panel on --halo, 1px solid #22303C, 1px #1B2731 divider	The key to the marker colour and numeral pairing.
21	Legend dot — level 4	30px circle · Mono 700 11px · #7A0F16 fill · #FFFFFF numeral · 4px #FF4D4D ring	Repeats the marker treatment at legend scale.
22	Legend chip — CAT	Mono 700 9px, .14em · #FF4D4D on --halo · 1px solid #FF4D4D	Static.
23	Legend band name — Catastrophic	Sans 500 12.5px · #C4D0DA	Static.
24	Legend count — 1	Mono 500 11px · #8B9AA8 · right-aligned	Live count over the currently active incidents.
25	Legend dot — level 3	26px circle · Mono 700 11px · #E03127 fill · #FFFFFF numeral · 3px #FF8078 ring	Repeats the marker treatment at legend scale.
26	Legend chip — EXT	Mono 700 9px, .14em · #FF8078 on --halo · 1px solid #FF8078	Static.
27	Legend band name — Extreme	Same as #23	Static.
28	Legend count — 2	Same as #24	Live count over the currently active incidents.
29	Legend dot — level 2	22px circle · Mono 700 11px · #F58021 fill · #1A0C02 numeral · 2px #FFB36B ring	Repeats the marker treatment at legend scale.
30	Legend chip — HIGH	Mono 700 9px, .14em · #FFB36B on --halo · 1px solid #FFB36B	Static.
31	Legend band name — High	Same as #23	Static.
32	Legend count — 1	Same as #24	Live count over the currently active incidents.
33	Legend dot — level 1	18px circle · Mono 700 11px · #F5C842 fill · #1A1405 numeral · 2px #FFE08A ring	Repeats the marker treatment at legend scale.
34	Legend chip — MOD	Mono 700 9px, .14em · #FFE08A on --halo · 1px solid #FFE08A	Static.
35	Legend band name — Moderate	Same as #23	Static.
36	Legend count — 1	Same as #24	Live count over the currently active incidents.
37	Zoom in +	30×30px · Mono 500 15px #A8B6C2 on --halo · 1px	Returns to Z2 and expands both clusters.


#	Element	Visual spec	Behaviour / interaction
		solid #2C3A48	
38	Zoom out –	As +	No-op at Z1: this is the widest zoom.
39	Zoom readout — Z1	39×23px · Mono 600 9px · #8B9AA8 on --halo · 1px solid #2C3A48	Confirms the clustered state; the sector bar repeats it in words.
40	Rail heading — Active Incidents	Mono 600 11px, .16em, uppercase · #E6EDF3	Unchanged by clustering.
41	Rail sub-line	Mono 400 11px · #8B9AA8	Unchanged.
42	Δ S3 change note	Mono 500 11px/1.5 · #9FE9E0 on accent @6% · 1px dashed #1D5B57 · Δ S3 marker Mono 700 11px #2BD9C8	Prototype commentary, not product UI. Toggled by the header Δ ON/OFF control.
43	Filter — All 5	Mono 600 10px · #04191A on #2BD9C8	Selected.
44	Filter — Sev 3–4	Mono 600 10px · #8B9AA8 · 1px solid #2C3A48	Restricts to Extreme and Catastrophic.
45	Filter — Extinguished 0	As above	Shows resolved incidents only.
46	Alerts & Suggested toggle	Accent @8% · 1px dashed #1D5B57 · #2BD9C8	Opens the alerts panel (state 3).
47	Toggle label	Mono 600 10px, .16em · #2BD9C8	Static.
48	Toggle count chip — 3	Mono 700 9px · #2BD9C8 · 1px solid #1D5B57	Open alerts and suggestions.
49	Toggle note	Mono 400 10px · #2BD9C8	GRP-04 needs your call.
50	Ranked row — INC-0428	361×60px · grid 36px / 1fr · 11/16px pad · 1px #161F28 divider · hover bg --surface-2 · newly inserted row bg --tint	Click opens Incident Detail. Rows are ordered severity first, then distance from staging; existing rows are never reordered out from under the user on insert.
51	Row severity dot — level 4	Max 30–38px · #7A0F16 fill · #FFFFFF numeral · 4px #FF4D4D ring	Same pairing as the map marker.
52	Row abbreviation chip — CAT	Same as #22	Static.
53	Row place — Ridge Rd, 3 km NE of Broadwater	Sans 500 12.5px · #D5DFE8	Static.
54	Row incident ID — INC-0428	Mono 400 10px · #8B9AA8	Static.
55	Row age — 31m ago	Same as #54	Advances with the clock.
56	Row confidence — conf 0.92	Mono 400 10px · #8B9AA8 (figure in the confidence colour)	The model confidence against the fixed 0.75 threshold.
57	Row source chip — DRONE	Mono 400 10px · #A8B6C2 · 1px solid #26333F	The input channel this image arrived on.
58	Ranked row — INC-0431	Same as #50	Click opens Incident Detail. Rows are ordered severity first, then distance from staging; existing rows are never reordered out from under the user on insert.
59	Row severity dot — level 3	Max 30–38px · #E03127 fill · #FFFFFF numeral · 3px #FF8078 ring	Same pairing as the map marker.
60	Row abbreviation chip — EXT	Same as #26	Static.
61	Row place — Simmons Creek Track	Same as #53	Static.
62	Row incident ID — INC-0431	Same as #54	Static.
63	Row age — 46m ago	Same as #54	Advances with the clock.
64	Row confidence — conf 0.88	Same as #56	The model confidence against the fixed 0.75 threshold.
65	Row source chip — SAT	Same as #57	The input channel this image arrived on.

#	Element	Visual spec	Behaviour / interaction
66	Ranked row — INC-0426	Same as #50	Click opens Incident Detail. Rows are ordered severity first, then distance from staging; existing rows are never reordered out from under the user on insert.
67	Row severity dot — level 3	Same as #59	Same pairing as the map marker.
68	Row abbreviation chip — EXT	Same as #26	Static.
69	Row place — Warrandale Rd culvert	Same as #53	Static.
70	Row incident ID — INC-0426	Same as #54	Static.
71	Row age — 1h 2m ago	Same as #54	Advances with the clock.
72	Row confidence — conf 0.83	Same as #56	The model confidence against the fixed 0.75 threshold.
73	Row source chip — MANUAL	Same as #57	The input channel this image arrived on.
74	Ranked row — INC-0419	Same as #50	Click opens Incident Detail. Rows are ordered severity first, then distance from staging; existing rows are never reordered out from under the user on insert.
75	Row severity dot — level 2	Max 30–38px · #F58021 fill · #1A0C02 numeral · 2px #FFB36B ring	Same pairing as the map marker.
76	Row abbreviation chip — HIGH	Same as #30	Static.
77	Row place — Kinglake NP eastern boundary	Same as #53	Static.
78	Row incident ID — INC-0419	Same as #54	Static.
79	Row age — 1h 25m ago	Same as #54	Advances with the clock.
80	Row confidence — conf 0.90	Same as #56	The model confidence against the fixed 0.75 threshold.
81	Row source chip — MANUAL	Same as #57	The input channel this image arrived on.
82	Ranked row — INC-0402	Same as #50	Click opens Incident Detail. Rows are ordered severity first, then distance from staging; existing rows are never reordered out from under the user on insert.
83	Row severity dot — level 1	Max 30–38px · #F5C842 fill · #1A1405 numeral · 2px #FFE08A ring	Same pairing as the map marker.
84	Row abbreviation chip — MOD	Same as #34	Static.
85	Row place — Old Mill Reserve	Same as #53	Static.
86	Row incident ID — INC-0402	Same as #54	Static.
87	Row age — 1h 53m ago	Same as #54	Advances with the clock.
88	Row confidence — conf 0.94	Same as #56	The model confidence against the fixed 0.75 threshold.
89	Row source chip — API	Same as #57	The input channel this image arrived on.
90	Flagged-queue strip	Accent @6% · 1px dashed #1D5B57 top border	Click → Manual Review.
91	Flagged strip badge	21px circle · 2px dashed #2BD9C8	Static.
92	Flagged strip text	Mono 400 11px · #9FE9E0	2 flagged · not drawn on the map until reviewed.
93	Flagged strip arrow →	Mono 600 10px · #2BD9C8	Static.

#	Element	Visual spec	Behaviour / interaction
94	Open full dispatch order (row)	Mono 600 11px · #2BD9C8 · 1px --border top	Click → Dispatch Order.
95	Open full dispatch order label	Mono 600 11px · #2BD9C8	Static.
96	Open full dispatch order arrow →	Same as #95	Static.

Figure 14 — State 3 — Alerts & Suggested rail (incident grouping: propose / confirm / split)

Opening this panel hides the Active Incidents list. Badges 50–58 are the grouping proposal itself; 59–71 the alerts beneath it.

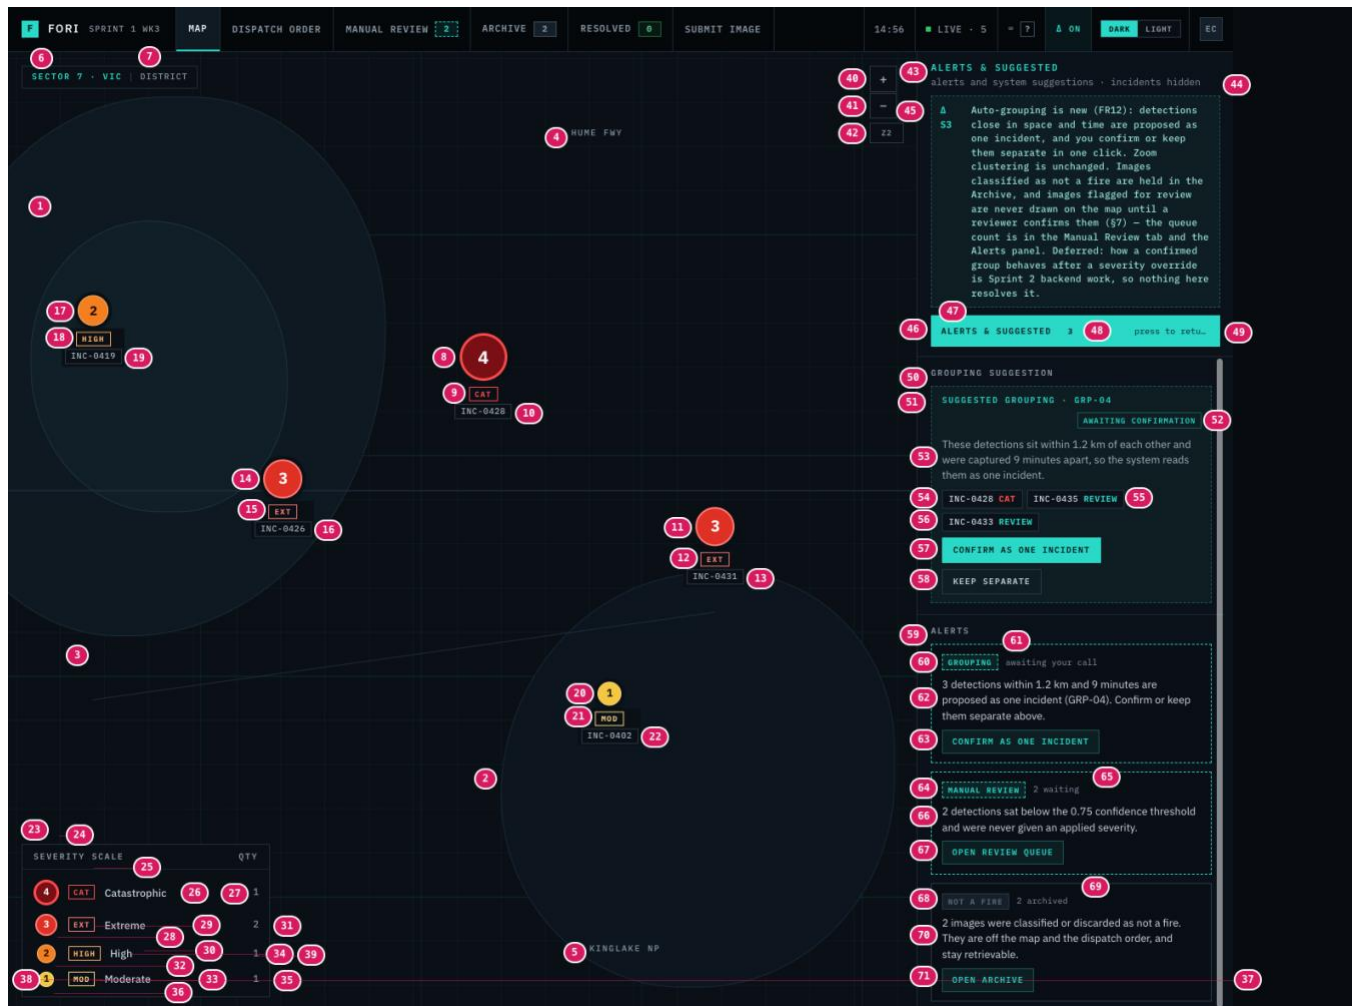

#	Element	Visual spec	Behaviour / interaction
1	Terrain shape 1	Organic blob · --ter-1 #0E1922 · 1px solid #1B2A33	Non-interactive backdrop; a stylised stand-in for a basemap, not geographic data.
2	Terrain shape 2	--ter-2 #112028 · 1px solid #1E323B	Non-interactive.
3	Contour band	--ter-line-2 #1E2C38 · 731×104px	Non-interactive.
4	Place label — HUME FWY	Mono 500 10px, .16em · #8B9AA8 · pointer-events none	Fixed obstacle in the marker deconfliction pass.
5	Place label — KINGLAKE NP	Mono 500 10px, .16em · #8B9AA8	As #4.
6	Sector label — SECTOR 7 · VIC	Mono 600 10px, .16em · #2BD9C8 on --halo · 1px solid #22303C · 7/11px pad	Static; a fixed string in the prototype.
7	Zoom name — DISTRICT	Mono 500 10px, .1em · #8B9AA8	Z2. The map itself is unchanged by opening this panel.
8	Marker numeral — level 4 (INC-0428)	58px overall (50px dot + 4px #FF4D4D ring) · #7A0F16 fill · #FFFFFF numeral · 4px #FF4D4D ring · Mono 700 21px	The numeral is the band level and the fill is that band colour. Click opens Incident Detail.
9	Marker abbreviation chip — CAT	Mono 700 9px, .14em · #FF4D4D on --halo · 1px solid #FF4D4D	Read-only label.
10	Marker ID chip — INC-0428	Mono 500 10px · #A8B6C2 on --halo · 1px solid	Read-only label.

#	Element	Visual spec	Behaviour / interaction
		#2C3A48	
11	Marker numeral — level 3 (INC-0431)	48px overall (42px + 3px #FF8078 ring) · #E03127 fill · #FFFFFF numeral · 3px #FF8078 ring · Mono 700 18px	The numeral is the band level and the fill is that band colour. Click opens Incident Detail.
12	Marker abbreviation chip — EXT	Mono 700 9px, .14em · #FF8078 on --halo · 1px solid #FF8078	Read-only label.
13	Marker ID chip — INC-0431	Same as #10	Read-only label.
14	Marker numeral — level 3 (INC-0426)	Same as #11	The numeral is the band level and the fill is that band colour. Click opens Incident Detail.
15	Marker abbreviation chip — EXT	Same as #12	Read-only label.
16	Marker ID chip — INC-0426	Same as #10	Read-only label.
17	Marker numeral — level 2 (INC-0419)	37px overall (34px + 2px #FFB36B ring) · #F58021 fill · #1A0C02 numeral · 2px #FFB36B ring · Mono 700 15px	The numeral is the band level and the fill is that band colour. Click opens Incident Detail.
18	Marker abbreviation chip — HIGH	Mono 700 9px, .14em · #FFB36B on --halo · 1px solid #FFB36B	Read-only label.
19	Marker ID chip — INC-0419	Same as #10	Read-only label.
20	Marker numeral — level 1 (INC-0402)	29px overall (26px + 2px #FFE08A ring) · #F5C842 fill · #1A1405 numeral · 2px #FFE08A ring · Mono 700 12px	The numeral is the band level and the fill is that band colour. Click opens Incident Detail.
21	Marker abbreviation chip — MOD	Mono 700 9px, .14em · #FFE08A on --halo · 1px solid #FFE08A	Read-only label.
22	Marker ID chip — INC-0402	Same as #10	Read-only label.
23	Legend header — SEVERITY SCALE / QTY	Mono 600 10px, .16em · #8B9AA8 · 290px panel on --halo · 1px solid #22303C	The key to the marker colour and numeral pairing.
24	Legend dot — level 4	30px circle · Mono 700 11px · #7A0F16 fill · #FFFFFF numeral · 4px #FF4D4D ring	Repeats the marker treatment at legend scale.
25	Legend chip — CAT	Same as #9	Static.
26	Legend band name — Catastrophic	Sans 500 12.5px · #C4D0DA	Static.
27	Legend count — 1	Mono 500 11px · #8B9AA8 · right-aligned	Live count over the currently active incidents.
28	Legend dot — level 3	26px circle · Mono 700 11px · #E03127 fill · #FFFFFF numeral · 3px #FF8078 ring	Repeats the marker treatment at legend scale.
29	Legend chip — EXT	Same as #12	Static.
30	Legend band name — Extreme	Same as #26	Static.
31	Legend count — 2	Same as #27	Live count over the currently active incidents.
32	Legend dot — level 2	22px circle · Mono 700 11px · #F58021 fill · #1A0C02 numeral · 2px #FFB36B ring	Repeats the marker treatment at legend scale.
33	Legend chip — HIGH	Same as #18	Static.
34	Legend band name — High	Same as #26	Static.
35	Legend count — 1	Same as #27	Live count over the currently active incidents.
36	Legend dot — level 1	18px circle · Mono 700 11px · #F5C842 fill · #1A1405 numeral · 2px #FFE08A ring	Repeats the marker treatment at legend scale.
37	Legend chip — MOD	Same as #21	Static.

#	Element	Visual spec	Behaviour / interaction
38	Legend band name — Moderate	Same as #26	Static.
39	Legend count — 1	Same as #27	Live count over the currently active incidents.
40	Zoom in +	30×30px · Mono 500 15px #A8B6C2 on --halo · 1px solid #2C3A48	Steps zoom up to Z3.
41	Zoom out –	As +	Steps zoom down to Z1.
42	Zoom readout — Z2	39×23px · Mono 600 9px · #8B9AA8 · 1px solid #2C3A48	Current zoom.
43	Rail heading — Alerts & Suggested	Mono 600 11px, .16em, uppercase · #2BD9C8	The rail heading switches from Active Incidents to Alerts & Suggested while the panel is open.
44	Rail sub-line	Mono 400 11px · #8B9AA8	alerts and system suggestions · incidents hidden — states the trade-off: the active incident list is not visible while this panel is open.
45	Δ S3 change note	Mono 500 11px/1.5 · #9FE9E0 on accent @6% · 1px dashed #1D5B57 · Δ S3 marker Mono 700 11px #2BD9C8	Prototype commentary, not product UI. Toggled by the header Δ ON/OFF control.
46	Panel toggle (pressed)	Solid #2BD9C8 fill · #04191A text · 1px solid #2BD9C8 · 9/11px pad	Click returns the rail to the incident list.
47	Toggle label — Alerts & Suggested	Mono 600 10px, .16em · #04191A	Static.
48	Toggle count chip — 3	Mono 700 9px · #04191A · 1px solid rgba(4,25,26,.35)	Number of open alerts and suggestions.
49	Toggle note — press to return	Mono 400 10px · #04191A	States how to get back to the incident list.
50	GROUPING SUGGESTION heading	Mono 600 10px, .16em, uppercase · #8B9AA8	Section label above the proposal card.
51	Proposal title — SUGGESTED GROUPING · GRP-04	Mono 600 10px, .14em · #2BD9C8 · card bg accent @6% · 1px dashed #1D5B57 · 11/12px pad	The proposal is generated automatically by proximity and time window but is never applied on its own.
52	Proposal state chip — AWAITING CONFIRMATION	Mono 600 9px, .1em · #2BD9C8 · 1px solid #1D5B57 · 4/6px pad	Three states: AWAITING CONFIRMATION (dashed, accent @6%), CONFIRMED BY YOU (solid, --tint), KEPT SEPARATE (solid, --surface, #8B9AA8 title).
53	Proposal rationale	Sans 400 12.5px/1.45 · #A8B6C2 · text-wrap: pretty	These detections sit within 1.2 km of each other and were captured 9 minutes apart, so the system reads them as one incident. Both figures are fixed strings in the build.
54	Member chip — INC-0428 CAT	Chip --panel · 1px solid #26333F · 5/7px pad · ID Mono 500 10px #D5DFE8 + band abbreviation Mono 700 in the band colour	Click opens that member's Incident Detail. Dismissed members drop out of the list.
55	Member chip — INC-0435 REVIEW	As above, abbreviation REVIEW in #2BD9C8	A flagged member shows REVIEW instead of a band.
56	Member chip — INC-0433 REVIEW	As above	A flagged member shows REVIEW instead of a band.
57	Confirm as one incident	Mono 600 10px, .1em, uppercase · #04191A on #2BD9C8 · 1px solid #2BD9C8 · 9/12px pad	Sets the group to CONFIRMED BY YOU, logs Grouping confirmed — 3 images treated as one incident (GRP-04), raises a toast with an Undo, and changes this action to Split into separate incidents. Member images stay individually inspectable.
58	Keep separate	Mono 600 10px, .1em, uppercase · #C4D0DA · transparent · 1px solid #2C3A48 · 9/12px pad	Sets the group to KEPT SEPARATE, logs Grouping rejected — images kept as separate incidents (GRP-04), and changes the action to Group as one incident.


#	Element	Visual spec	Behaviour / interaction
			The suggestion can be re-applied at any time.
59	ALERTS heading	Same as #50	Section label.
60	Alert tag — GROUPING	Mono 700 9px, .12em · #2BD9C8 on accent @10% · card 1px dashed #1D5B57 on --surface · 11/12px pad	Alerts are generated for an open grouping proposal, items waiting in review, live crews and archived not-a-fire images.
61	Alert timing — awaiting your call	Mono 400 10px · #8B9AA8	States urgency, not a timestamp.
62	Alert body	Sans 400 12.5px/1.5 · #D5DFE8	3 detections within 1.2 km and 9 minutes may be one incident.
63	Alert CTA — Confirm as one incident	Mono 600 10px, .1em, uppercase · #2BD9C8 on accent @8% · 1px solid #1D5B57	Duplicate route to the same confirm action as #57.
64	Alert tag — MANUAL REVIEW	Mono 700 9px, .12em · #2BD9C8 on accent @10%	Second alert card.
65	Alert timing — 2 waiting	Same as #61	Live count of the review queue.
66	Alert body	Same as #62	2 detections sat below the 0.75 confidence threshold and are held out of the dispatch order.
67	Alert CTA — Open review queue	Same as #63	Click → Manual Review.
68	Alert tag — NOT A FIRE	Mono 700 9px, .12em · #5C6B77 on --surface-3 #16202A · 1px solid #2C3A48	Grey treatment marks an informational alert rather than one needing a decision.
69	Alert timing — 2 archived	Same as #61	Live count of the Archive.
70	Alert body	Same as #62	2 images were classified or discarded as not a fire and are off the map.
71	Alert CTA — Open archive	Same as #63	Click → Archive · Not a Fire.

Archive / Resolved

Two separate screens of the same construction: a title block, a Δ change note, and a bordered table on --panel with a --surface header row. They are deliberately kept apart — Archive holds images that were never incidents (not a fire), Resolved holds real incidents that ended (extinguished). Both keep the full record and offer a one-click return path.

Figure 15 — Archive · Not a Fire

Two rows in the built dataset: one dismissed by the AI classification gate (badges 13–22), one discarded by a reviewer (23–32).

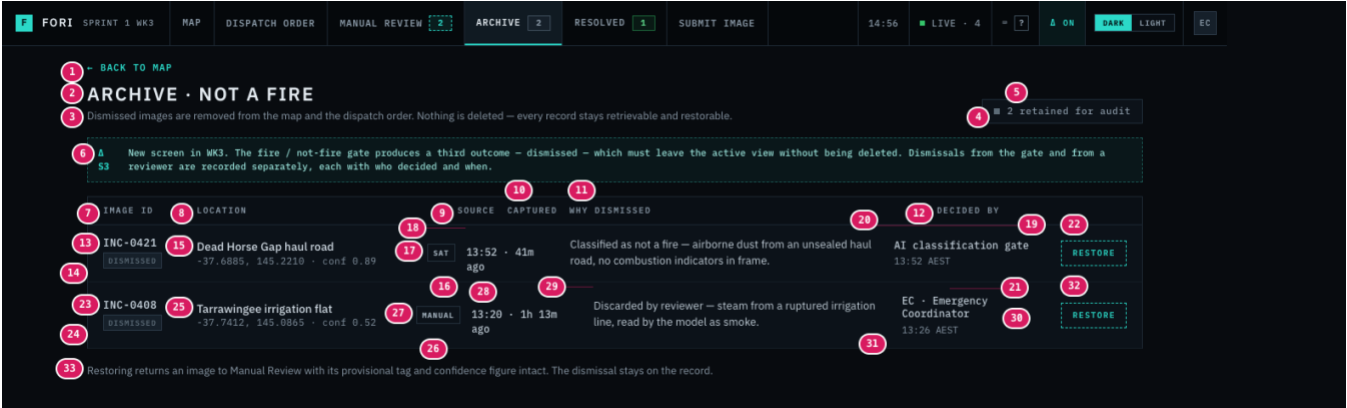


#	Element	Visual spec	Behaviour / interaction
1	← Back to map	Mono 600 11px, .1em, uppercase · #2BD9C8	Click → Map.
2	Screen title — Archive · Not a Fire	Sans 600 22px/1.2, .08em, uppercase · #E6EDF3	Static.
3	Screen description	Sans 400 12.5px/1.4 · #8B9AA8	Dismissed images are removed from the map and the dispatch order. Nothing is deleted — every record stays retrievable and restorable.
4	Counter marker	7×7px square · #5C6B77	Grey marker; the Resolved screen uses a green one.
5	Counter — 2 retained for audit	Mono 500 11px, .06em · #8B9AA8 · bg --panel · 1px solid #22303C · 8/13px pad	Live count. Matches the ARCHIVE tab badge (Mono 700 10px #8B9AA8 on --surface-3, 1px solid #42525F).
6	Δ S3 change note	Mono 500 11px/1.5 · #9FE9E0 on accent @6% · 1px dashed #1D5B57 · Δ S3 marker Mono 700 11px #2BD9C8	Prototype commentary, not product UI. Toggled by the header Δ ON/OFF control.
7	Column head — IMAGE ID	Mono 600 10px, .14em, uppercase · #8B9AA8 · header row bg --surface · 1px --border bottom · 11/18px pad · 14px column gap	Static; no sorting. Grid: min 96px / 1.4fr / auto / auto / 2fr / 1fr / auto.
8	Column head — LOCATION	As #7	Static.
9	Column head — SOURCE	Same as #8	Static.
10	Column head — CAPTURED	Same as #8	Static.
11	Column head — WHY DISMISSED	Same as #8	Static.
12	Column head — DECIDED BY	Same as #8	Static. The seventh column, the Restore action, carries no label.
13	Image ID — INC-0421	Mono 600 12px, .06em · #C4D0DA	Not a link: unlike the Resolved screen, the Archive id is plain text.
14	DISMISSED chip	Mono 600 9px, .1em, uppercase · #5C6B77 on --surface-3 #16202A · 1px solid #2C3A48 · 4/5px pad	How a dismissed record is presented. It shares the --surface-3 ground with the EXTINGUISHED chip on the Resolved screen and differs only in text and border colour (see Open items).

#	Element	Visual spec	Behaviour / interaction
15	Location — Dead Horse Gap haul road	Sans 500 13.5px/1.35 · #D5DFE8	Static.
16	Location sub-line	Mono 400 11px · #8B9AA8	-37.6885, 145.2210 · conf 0.89 — the confidence of the not-a-fire call, not of a severity.
17	Source chip — SAT	Mono 700 9px, .1em · #A8B6C2 · 1px solid #26333F · 5/6px pad · tooltip gives the full channel name	The input channel is retained on dismissed records.
18	Captured — 13:52 · 41m ago	Mono 500 12px/1.4 · #C4D0DA	Relative age advances with the clock.
19	Why dismissed	Sans 400 13px/1.45 · #C4D0DA · text-wrap: pretty	Classified as not a fire — airborne dust from a haul truck, no thermal signature or smoke column. The AI-gate wording begins Classified as not a fire.
20	Decided by — AI classification gate	Mono 500 12px · #C4D0DA	Distinguishes an automatic dismissal from a reviewer's.
21	Decided at — 13:52 AEST	Same as #16	When the gate ran.
22	RESTORE button	Mono 600 10px, .12em, uppercase · #2BD9C8 · transparent · 1px dashed #2BD9C8 · 9/12px pad · hover bg accent @14%	Returns the image to the Manual Review queue with its provisional tag and confidence intact, marks the queue reason restored · was not a fire, logs the restore, navigates to Manual Review and raises a toast. The original dismissal stays on the record.
23	Image ID — INC-0408	Same as #13	Second row.
24	DISMISSED chip	As #14	Same treatment for both dismissal provenances.
25	Location — Tarrawingee irrigation flat	Same as #15	Static.
26	Location sub-line	Same as #16	-37.7412, 145.0865 · conf 0.52.
27	Source chip — MANUAL	As #17	Manual upload.
28	Captured — 13:20 · 1h 13m ago	Same as #18	Relative age.
29	Why dismissed	Sans 400 13px/1.45 · #C4D0DA	Discarded by reviewer — steam from a ruptured irrigation line, confirmed by a second image. The reviewer wording begins Discarded by reviewer, which is how the two provenances are told apart.
30	Decided by — EC · Emergency Coordinator	Same as #20	A human dismissal, from the Discard action in Manual Review.
31	Decided at — 13:26 AEST	Same as #16	When the reviewer discarded it.
32	RESTORE button	As #22	Returns the image to Manual Review marked restored · was discarded.
33	Footer note	Sans 400 12.5px/1.5 · #8B9AA8 · max-width 820px	Restoring returns an image to Manual Review with its provisional tag and confidence figure intact. The dismissal stays on the record. Empty state (not shown): Nothing has been dismissed. Images classified as not a fire, and images a reviewer discards, are listed here.

Figure 16 — Resolved · Extinguished

Captured after dispatching INC-0428 and marking it extinguished.

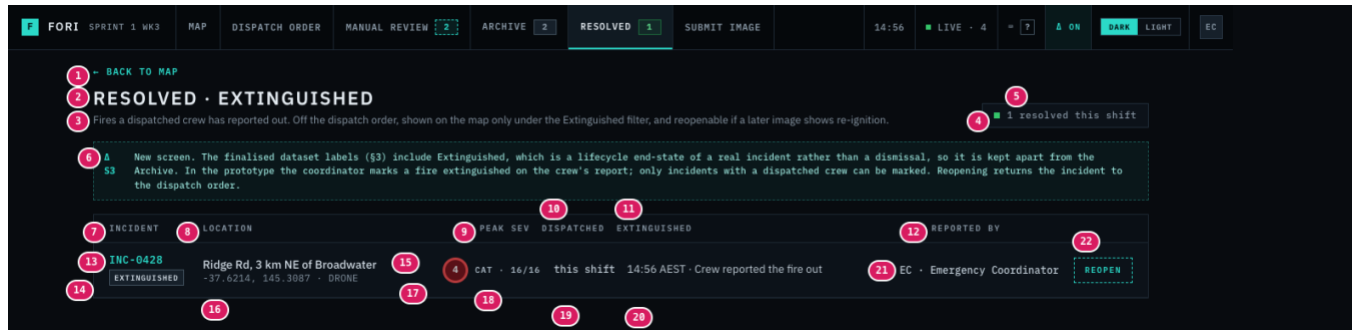

#	Element	Visual spec	Behaviour / interaction
1	← Back to map	Mono 600 11px, .1em, uppercase · #2BD9C8	Click → Map.
2	Screen title — Resolved · Extinguished	Sans 600 22px/1.2, .08em, uppercase · #E6EDF3	Static.
3	Screen description	Sans 400 12.5px/1.4 · #8B9AA8	Fires a dispatched crew has reported out. Off the dispatch order, shown on the map only under the Extinguished filter, and reopenable if a later image shows re-ignition.
4	Counter marker	7×7px square · #35C46A	Green marker distinguishes this screen from the Archive's grey one.
5	Counter — 1 resolved this shift	Mono 500 11px, .06em · #8B9AA8 · bg --panel · 1px solid #22303C · 8/13px pad	Live count. Matches the RESOLVED tab badge (#5FD98C on green @9%, 1px solid #1E6B3D).
6	Δ S3 change note	Mono 500 11px/1.5 · #9FE9E0 on accent @6% · 1px dashed #1D5B57 · Δ S3 marker Mono 700 11px #2BD9C8	Prototype commentary, not product UI. Toggled by the header Δ ON/OFF control.
7	Column head — INCIDENT	Mono 600 10px, .14em, uppercase · #8B9AA8 · header row bg --surface · 1px --border bottom · 11/18px pad	Static. Grid: min 96px / 1.4fr / auto / auto / 1.6fr / 1fr / auto.
8	Column head — LOCATION	As #7	Static.
9	Column head — PEAK SEV	Same as #8	Static.
10	Column head — DISPATCHED	Same as #8	Static.
11	Column head — EXTINGUISHED	Same as #8	Static.
12	Column head — REPORTED BY	Same as #8	Static. The seventh column, the Reopen action, carries no label.
13	Incident ID link — INC-0428	Mono 600 12px, .06em · #2BD9C8 · hover #7FEFE3 · focusable	Click opens Incident Detail for the resolved incident. Unlike the Archive, the id here is a link.
14	EXTINGUISHED chip	Mono 600 9px, .1em, uppercase · #D5DFE8 on --surface-3 #16202A · 1px solid #42525F · 4/5px pad	The distinguishing mark against the Archive's DISMISSED chip: lighter text and a stronger border on the same ground.
15	Location — Ridge Rd, 3 km NE of Broadwater	Sans 500 13.5px/1.35 · #D5DFE8	Static.
16	Location sub-line	Mono 400 11px · #8B9AA8	-37.6214, 145.3087 · DRONE — the source channel is retained on resolved incidents.
17	Peak severity dot — level 4	24px circle at 70% opacity · Mono 700 10px · #7A0F16 fill, #FFFFFF numeral, 4px #FF4D4D ring	The faded dot signals a historic severity rather than a live one.


#	Element	Visual spec	Behaviour / interaction
18	Peak severity label — CAT · 16/16	Mono 600 10px, .1em · #A8B6C2	Peak severity and the element sum are kept on the record.
19	Dispatched — this shift	Mono 500 12px/1.4 · #C4D0DA	A fixed placeholder string: no dispatch timestamp is stored when a crew is assigned, so response-time reporting is not possible from this record (see Open items).
20	Extinguished — 14:56 AEST · Crew reported the fire out	Sans 400 13px/1.45 · #C4D0DA	The time plus the note captured when the coordinator marked the incident out.
21	Reported by — EC · Emergency Coordinator	Mono 500 12px · #C4D0DA	The coordinator who recorded the crew's report.
22	REOPEN button	Mono 600 10px, .12em, uppercase · #2BD9C8 · transparent · 1px dashed #2BD9C8 · 9/12px pad · hover bg accent @14%	Clears the extinguished state, returns the incident to LIVE / DISPATCHED in the dispatch order, logs Reopened — back on the dispatch order under Live / Dispatched, and raises a toast whose Undo re-extinguishes it. Empty state (not shown): Nothing resolved yet. Dispatch a crew, then mark the incident extinguished from the dispatch order or its detail screen when the crew reports it out.

Dispatch Order (Awaiting / Live)

One scrolling table, max-width 1240 px, on a shared 7-column grid: 52 / 58 / 1fr / 1.5fr / 96 / 74 / 128 px, 14 px gap, 14/18 px row padding, 1 px #161F28 row dividers. A filter row above shows All / Awaiting dispatch / Live / dispatched with live counts; the two sections below are colour-coded (accent for awaiting, green for live) and can be shown alone. Every field on every row is numbered individually.

Figure 17 — State 1 — Awaiting dispatch (no crews out)

Entry state. Five ranked incidents (badges 19–78), two flagged images held out of the ranking (79–100), and an empty Live section (101–104).

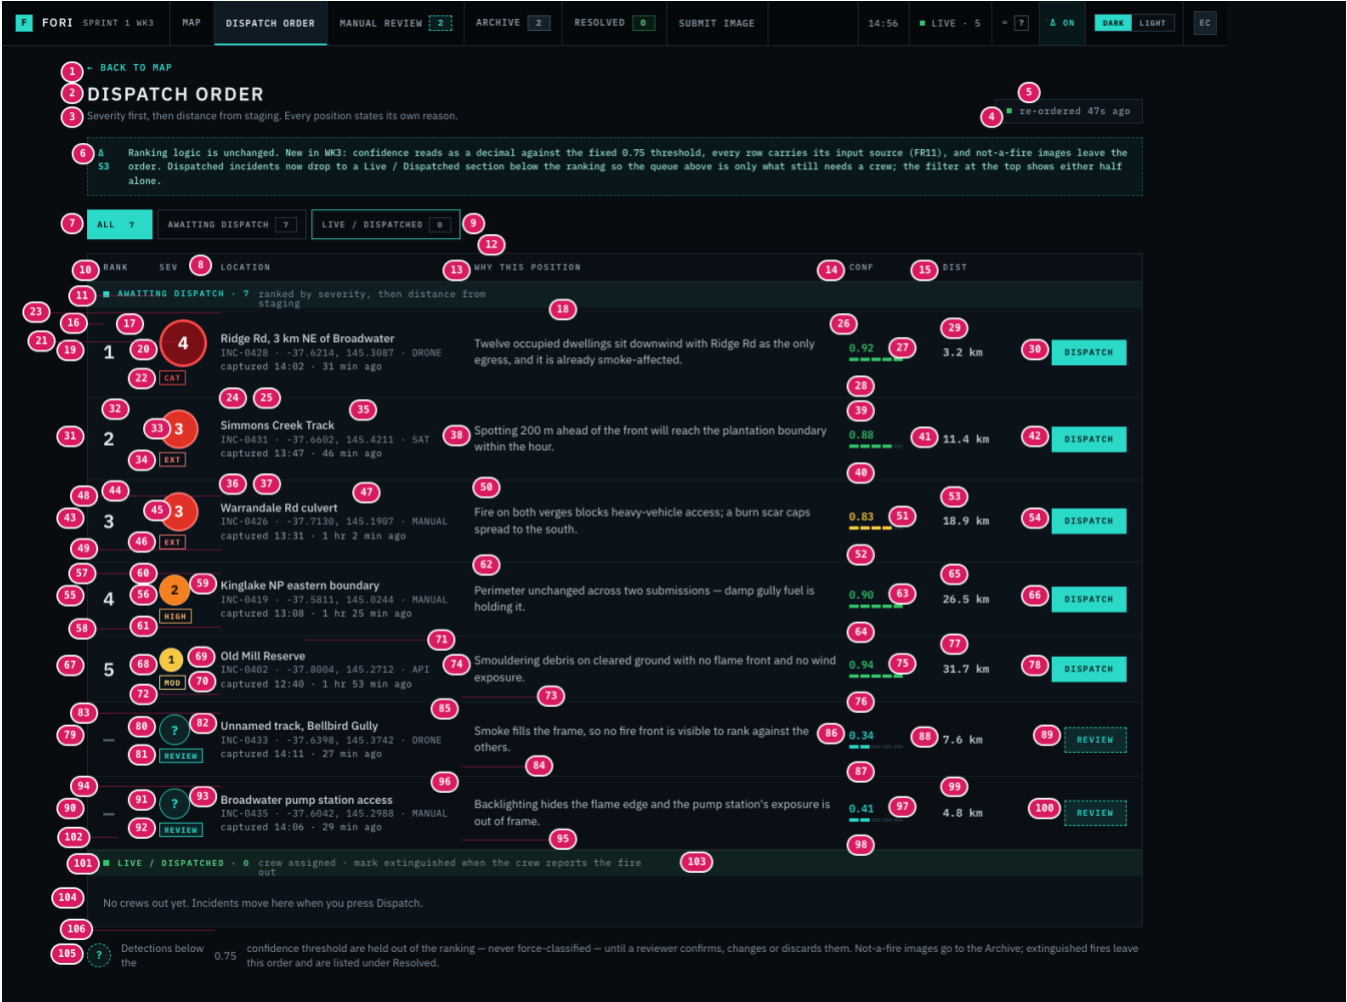

#	Element	Visual spec	Behaviour / interaction
1	← Back to map	Mono 600 11px, .1em, uppercase · #2BD9C8 · hover #7FEFE3	Click → Map.
2	Screen title — Dispatch Order	Sans 600 22px/1.2, .08em, uppercase · #E6EDF3	Static.
3	Ranking rule	Sans 400 12.5px/1.4 · #8B9AA8	Severity first, then distance from staging. Every position states its own reason. The rule is stated in the interface, not just in the data.
4	Re-order stamp marker	6×6px square · #35C46A	Marks the freshness stamp.
5	Re-order stamp — re-ordered 47s ago	Mono 500 11px, .06em · #8B9AA8 · bg --panel · 1px solid #22303C · 8/13px pad	Ticks with the clock.
6	Δ S3 change note	Mono 500 11px/1.5 · #9FE9E0 on accent @6% · 1px dashed #1D5B57 · Δ S3 marker Mono 700 11px #2BD9C8	Prototype commentary, not product UI. Toggled by the header Δ ON/OFF control.

#	Element	Visual spec	Behaviour / interaction
7	Filter — All 7	Mono 600 10px, .1em, uppercase · #04191A on #2BD9C8 · 1px solid #2BD9C8 · 8/11px pad · count chip Mono 700 9px	Shows both sections. aria-pressed is set on the active filter.
8	Filter — Awaiting dispatch 7	Mono 600 10px, .1em, uppercase · #8B9AA8 · transparent · 1px solid #2C3A48 · count chip Mono 700 9px	Shows the awaiting section alone. The count updates immediately on dispatch.
9	Filter — Live / dispatched 0	As #8	Shows the live section alone.
10	Column head — RANK	Mono 600 10px, .14em, uppercase · #8B9AA8 · header row bg --surface · 1px --border bottom · 11/18px pad	Static; no sorting in the build.
11	Column head — SEV	As #10	Static.
12	Column head — LOCATION	Same as #11	Static.
13	Column head — WHY THIS POSITION	Same as #11	Static.
14	Column head — CONF	Same as #11	Static.
15	Column head — DIST	Same as #11	Static. The seventh column, actions, carries no label.
16	Awaiting section marker	7×7px square · #2BD9C8	The accent square and bar are the awaiting signal; the live section below uses green.
17	AWAITING DISPATCH · 7	Mono 600 10px, .14em, uppercase · #2BD9C8 · bar bg accent @6% · 1px #161F28 bottom · 9/18px pad	Live count of unranked-out incidents awaiting a crew.
18	Awaiting section note	Mono 400 11px · #8B9AA8	ranked by severity, then distance from staging.
19	Row container — INC-0428	Grid 52 / 58 / 1fr / 1.5fr / 96 / 74 / 128px · 14px gap · 14/18px pad · --panel #0C1219 · 1px #161F28 bottom divider · hover bg --surface-2 · whole row focusable	Click anywhere on the row opens Incident Detail for this incident.
20	Rank cell — 1	Mono 600 22px · #E6EDF3	Position in the ranking. Ranks are recomputed over the awaiting set only, so dispatching an incident rennumbers everything below it.
21	Severity numeral — 4	Mono 700 21px inside a 58px dot · #7A0F16 fill · #FFFFFF numeral · 4px #FF4D4D ring	Same colour and numeral pairing as the map marker.
22	Severity abbreviation chip — CAT	Mono 700 9px, .12em · #FF4D4D on --halo · 1px solid #FF4D4D	Static.
23	Location — Ridge Rd, 3 km NE of Broadwater	Sans 500 13.5px/1.3 · #D5DFE8 · ellipsised	Static.
24	Location meta	Same as #18	INC-0428 · -37.6214, 145.3087 · DRONE — every row carries its incident id, coordinates and input channel.
25	Capture line	Mono 400 11px · #A8B6C2	captured 14:02 · 31 min ago. Relative age advances with the clock.
26	Why this position	Sans 400 13.5px/1.45 · #C4D0DA	Twelve occupied dwellings sit downwind within 800 m and Ridge Rd is the only sealed egress.
27	Confidence figure — 0.92	Mono 600 12px · #35C46A	The model confidence against the fixed 0.75 threshold.
28	Confidence segments	Five 11×4px segments · filled in the confidence colour, empty #1B2731	Segment count = round(confidence / 20), minimum 1.
29	Distance — 3.2 km	Mono 600 13px · #C4D0DA	Distance from staging, the second sort key after severity.
30	Row action — Dispatch	Mono 600 10px, .12em, uppercase · #04191A on #2BD9C8 · 1px solid #2BD9C8 · 9/14px pad	Assigns a crew: the row leaves this section and reappears under LIVE / DISPATCHED, the status flag

#	Element	Visual spec	Behaviour / interaction
			becomes Dispatched and the toast Crew dispatched to INC-0428 · Tanker 12 en route appears. The click is not stopped from the row, so pressing Dispatch also opens the incident detail screen — and the built green Dispatched button state is therefore unreachable (see Open items).
31	Row container — INC-0431	Same as #19	Click anywhere on the row opens Incident Detail for this incident.
32	Rank cell — 2	Same as #20	Position in the ranking. Ranks are recomputed over the awaiting set only, so dispatching an incident renumbers everything below it.
33	Severity numeral — 3	Mono 700 18px inside a 48px dot · #E03127 fill · #FFFFFF numeral · 3px #FF8078 ring	Same colour and numeral pairing as the map marker.
34	Severity abbreviation chip — EXT	Mono 700 9px, .12em · #FF8078 on --halo · 1px solid #FF8078	Static.
35	Location — Simmons Creek Track	Same as #23	Static.
36	Location meta	Same as #18	INC-0431 · -37.6602, 145.4211 · SAT — every row carries its incident id, coordinates and input channel.
37	Capture line	Same as #25	captured 13:47 · 46 min ago. Relative age advances with the clock.
38	Why this position	Same as #26	Spotting 200 m ahead of the front will reach the plantation edge before the next pass.
39	Confidence figure — 0.88	Same as #27	The model confidence against the fixed 0.75 threshold.
40	Confidence segments	Same as #28	Segment count = round(confidence / 20), minimum 1.
41	Distance — 11.4 km	Same as #29	Distance from staging, the second sort key after severity.
42	Row action — Dispatch	Same as #30	Assigns a crew: the row leaves this section and reappears under LIVE / DISPATCHED, the status flag becomes Dispatched and the toast Crew dispatched to INC-0431 · Tanker 12 en route appears. The click is not stopped from the row, so pressing Dispatch also opens the incident detail screen — and the built green Dispatched button state is therefore unreachable (see Open items).
43	Row container — INC-0426	Same as #19	Click anywhere on the row opens Incident Detail for this incident.
44	Rank cell — 3	Same as #20	Position in the ranking. Ranks are recomputed over the awaiting set only, so dispatching an incident renumbers everything below it.
45	Severity numeral — 3	Same as #33	Same colour and numeral pairing as the map marker.
46	Severity abbreviation chip — EXT	Same as #34	Static.
47	Location — Warrandale Rd culvert	Same as #23	Static.
48	Location meta	Same as #18	INC-0426 · -37.7130, 145.1907 · MANUAL — every row carries its incident id, coordinates and input channel.


#	Element	Visual spec	Behaviour / interaction
49	Capture line	Same as #25	captured 13:31 · 1 hr 2 min ago. Relative age advances with the clock.
50	Why this position	Same as #26	Fire on both verges blocks heavy-vehicle access to everything north of the culvert.
51	Confidence figure — 0.83	Mono 600 12px · #F5C842	The model confidence against the fixed 0.75 threshold.
52	Confidence segments	Same as #28	Segment count = round(confidence / 20), minimum 1.
53	Distance — 18.9 km	Same as #29	Distance from staging, the second sort key after severity.
54	Row action — Dispatch	Same as #30	Assigns a crew: the row leaves this section and reappears under LIVE / DISPATCHED, the status flag becomes Dispatched and the toast Crew dispatched to INC-0426 · Tanker 12 en route appears. The click is not stopped from the row, so pressing Dispatch also opens the incident detail screen — and the built green Dispatched button state is therefore unreachable (see Open items).
55	Row container — INC-0419	Same as #19	Click anywhere on the row opens Incident Detail for this incident.
56	Rank cell — 4	Same as #20	Position in the ranking. Ranks are recomputed over the awaiting set only, so dispatching an incident rennumbers everything below it.
57	Severity numeral — 2	Mono 700 15px inside a 37px dot · #F58021 fill · #1A0C02 numeral · 2px #FFB36B ring	Same colour and numeral pairing as the map marker.
58	Severity abbreviation chip — HIGH	Mono 700 9px, .12em · #FFB36B on --halo · 1px solid #FFB36B	Static.
59	Location — Kinglake NP eastern boundary	Same as #23	Static.
60	Location meta	Same as #18	INC-0419 · -37.5811, 145.0244 · MANUAL — every row carries its incident id, coordinates and input channel.
61	Capture line	Same as #25	captured 13:08 · 1 hr 25 min ago. Relative age advances with the clock.
62	Why this position	Same as #26	Perimeter unchanged across two submissions, and no assets sit inside the current spread.
63	Confidence figure — 0.90	Same as #27	The model confidence against the fixed 0.75 threshold.
64	Confidence segments	Same as #28	Segment count = round(confidence / 20), minimum 1.
65	Distance — 26.5 km	Same as #29	Distance from staging, the second sort key after severity.
66	Row action — Dispatch	Same as #30	Assigns a crew: the row leaves this section and reappears under LIVE / DISPATCHED, the status flag becomes Dispatched and the toast Crew dispatched to INC-0419 · Tanker 12 en route appears. The click is not stopped from the row, so pressing Dispatch also opens the incident detail screen — and the built green Dispatched button state is therefore unreachable (see Open items).
67	Row container — INC-0402	Same as #19	Click anywhere on the row opens Incident Detail for this incident.

#	Element	Visual spec	Behaviour / interaction
68	Rank cell — 5	Same as #20	Position in the ranking. Ranks are recomputed over the awaiting set only, so dispatching an incident renumbers everything below it.
69	Severity numeral — 1	Mono 700 12px inside a 29px dot · #F5C842 fill · #1A1405 numeral · 2px #FFE08A ring	Same colour and numeral pairing as the map marker.
70	Severity abbreviation chip — MOD	Mono 700 9px, .12em · #FFE08A on --halo · 1px solid #FFE08A	Static.
71	Location — Old Mill Reserve	Same as #23	Static.
72	Location meta	Same as #18	INC-0402 · -37.8004, 145.2712 · API — every row carries its incident id, coordinates and input channel.
73	Capture line	Same as #25	captured 12:40 · 1 hr 53 min ago. Relative age advances with the clock.
74	Why this position	Same as #26	Smouldering debris on cleared ground with a sealed road on three sides.
75	Confidence figure — 0.94	Same as #27	The model confidence against the fixed 0.75 threshold.
76	Confidence segments	Same as #28	Segment count = round(confidence / 20), minimum 1.
77	Distance — 31.7 km	Same as #29	Distance from staging, the second sort key after severity.
78	Row action — Dispatch	Same as #30	Assigns a crew: the row leaves this section and reappears under LIVE / DISPATCHED, the status flag becomes Dispatched and the toast Crew dispatched to INC-0402 · Tanker 12 en route appears. The click is not stopped from the row, so pressing Dispatch also opens the incident detail screen — and the built green Dispatched button state is therefore unreachable (see Open items).
79	Row container — INC-0433	Grid 52 / 58 / 1fr / 1.5fr / 96 / 74 / 128px · 14px gap · 14/18px pad · --surface #0A0F15 · 1px #161F28 bottom divider · hover bg --surface-2 · whole row focusable	Click anywhere on the row opens Incident Detail for this incident. Flagged rows are shown for visibility but are not ranked and cannot be dispatched; their rank cell renders an em dash in #5C6B77.
80	Rank cell — ? (flagged, unranked)	Mono 700 13px · #2BD9C8	The rank column renders an em dash in #5C6B77 for a flagged row; the badge sits on the dashed accent “?” dot beside it, which is the element specified here. Flagged rows are never given a queue position.
81	Flag chip — REVIEW	Mono 700 9px, .12em · #2BD9C8 on accent @10% · 1px dashed #2BD9C8	Marks the row as awaiting a reviewer decision. The 34px dot beside it is dashed accent with a question mark.
82	Location — Unnamed track, Bellbird Gully	Same as #23	Static.
83	Location meta	Same as #18	INC-0433 · -37.6398, 145.3742 · DRONE — every row carries its incident id, coordinates and input channel.
84	Capture line	Same as #25	captured 14:11 · 27 min ago. Relative age advances with the clock.
85	Why this position	Same as #26	Smoke fills the frame, so no fire front is visible to rank against the others.
86	Confidence figure — 0.34	Mono 600 12px · #2BD9C8	The model confidence against the fixed 0.75 threshold.
87	Confidence segments	Same as #28	Segment count = round(confidence / 20), minimum 1.

#	Element	Visual spec	Behaviour / interaction
88	Distance — 7.6 km	Same as #29	Distance from staging, the second sort key after severity.
89	Row action — Review	Mono 600 10px, .12em, uppercase · #2BD9C8 on accent @12% · 1px dashed #2BD9C8 · 9/14px pad	Opens this image in Manual Review instead of dispatching it. Flagged images cannot be dispatched.
90	Row container — INC-0435	Same as #79	Click anywhere on the row opens Incident Detail for this incident. Flagged rows are shown for visibility but are not ranked and cannot be dispatched; their rank cell renders an em dash in #5C6B77.
91	Rank cell — ? (flagged, unranked)	Same as #80	The rank column renders an em dash in #5C6B77 for a flagged row; the badge sits on the dashed accent “?” dot beside it, which is the element specified here. Flagged rows are never given a queue position.
92	Flag chip — REVIEW	Same as #81	Marks the row as awaiting a reviewer decision. The 34px dot beside it is dashed accent with a question mark.
93	Location — Broadwater pump station access	Same as #23	Static.
94	Location meta	Same as #18	INC-0435 · -37.6042, 145.2988 · MANUAL — every row carries its incident id, coordinates and input channel.
95	Capture line	Same as #25	captured 14:06 · 29 min ago. Relative age advances with the clock.
96	Why this position	Same as #26	Backlighting hides the flame edge and the exposure around the pump station.
97	Confidence figure — 0.41	Same as #86	The model confidence against the fixed 0.75 threshold.
98	Confidence segments	Same as #28	Segment count = round(confidence / 20), minimum 1.
99	Distance — 4.8 km	Same as #29	Distance from staging, the second sort key after severity.
100	Row action — Review	Same as #89	Opens this image in Manual Review instead of dispatching it. Flagged images cannot be dispatched.
101	Live section marker	7×7px square · #35C46A	Green is the live signal throughout the build.
102	LIVE / DISPATCHED · 0	Mono 600 10px, .14em, uppercase · #5FD98C · bar bg green @9% · 1px --border top, 1px #161F28 bottom · 9/18px pad	Live count of crews out.
103	Live section note	Same as #18	crew assigned · mark extinguished when the crew reports the fire out.
104	Live section empty state	Sans 400 13px/1.5 · #8B9AA8 · 22/18px pad	No crews out yet. Incidents move here when you press Dispatch. The awaiting section has its own equivalent: Every ranked incident has a crew assigned.
105	Threshold footnote badge	29px circle · 2px dashed #2BD9C8 · Mono 700 11px #2BD9C8 question mark	Marker for the footnote.
106	Threshold footnote — 0.75	Sans 400 12.5px/1.4 · #8B9AA8 (figure inline)	Detections below the 0.75 confidence threshold are held out of the ranking — never force-classified — until a reviewer confirms, changes or discards them. Not-a-fire images go to the Archive; extinguished fires leave this order and are listed under Resolved.

Figure 18 — State 2 — Live / dispatched (one crew out)

After pressing Dispatch on INC-0428. The awaiting section rennumbers from 1, and the dispatched incident appears in the Live section (badges 92–103).

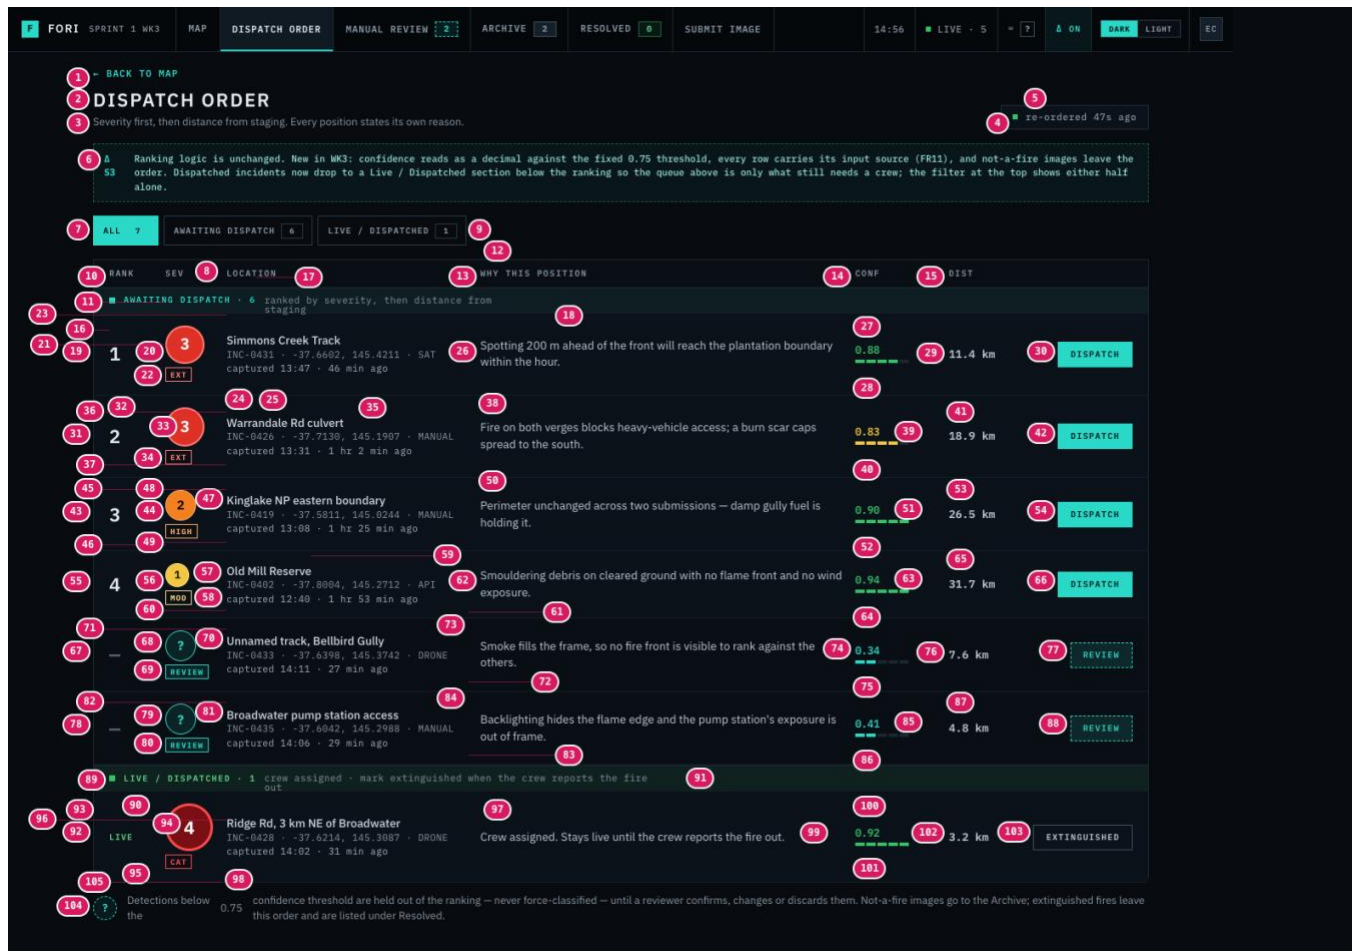

#	Element	Visual spec	Behaviour / interaction
1	← Back to map	Mono 600 11px, .1em, uppercase · #2BD9C8 · hover #7FEFE3	Click → Map.
2	Screen title — Dispatch Order	Sans 600 22px/1.2, .08em, uppercase · #E6EDF3	Static.
3	Ranking rule	Sans 400 12.5px/1.4 · #8B9AA8	Severity first, then distance from staging. Every position states its own reason. The rule is stated in the interface, not just in the data.
4	Re-order stamp marker	6×6px square · #35C46A	Marks the freshness stamp.
5	Re-order stamp — re-ordered 47s ago	Mono 500 11px, .06em · #8B9AA8 · bg --panel · 1px solid #22303C · 8/13px pad	Ticks with the clock.
6	Δ S3 change note	Mono 500 11px/1.5 · #9FE9E0 on accent @6% · 1px dashed #1D5B57 · Δ S3 marker Mono 700 11px #2BD9C8	Prototype commentary, not product UI. Toggled by the header Δ ON/OFF control.
7	Filter — All 7	Mono 600 10px, .1em, uppercase · #04191A on #2BD9C8 · 1px solid #2BD9C8 · 8/11px pad · count chip Mono 700 9px	Shows both sections. aria-pressed is set on the active filter.
8	Filter — Awaiting dispatch 6	Mono 600 10px, .1em, uppercase · #8B9AA8 · transparent · 1px solid #2C3A48 · count chip Mono 700 9px	Shows the awaiting section alone. The count updates immediately on dispatch.
9	Filter — Live / dispatched 1	As #8	Shows the live section alone.

#	Element	Visual spec	Behaviour / interaction
10	Column head — RANK	Mono 600 10px, .14em, uppercase · #8B9AA8 · header row bg --surface · 1px --border bottom · 11/18px pad	Static; no sorting in the build.
11	Column head — SEV	As #10	Static.
12	Column head — LOCATION	Same as #11	Static.
13	Column head — WHY THIS POSITION	Same as #11	Static.
14	Column head — CONF	Same as #11	Static.
15	Column head — DIST	Same as #11	Static. The seventh column, actions, carries no label.
16	Awaiting section marker	7×7px square · #2BD9C8	Unchanged.
17	AWAITING DISPATCH · 6	Mono 600 10px, .14em, uppercase · #2BD9C8 · bar bg accent @6%	Count drops by one and the remaining rows are renumbered: the former rank 2 becomes rank 1.
18	Awaiting section note	Mono 400 11px · #8B9AA8	Unchanged.
19	Row container — INC-0431	Grid 52 / 58 / 1fr / 1.5fr / 96 / 74 / 128px · 14px gap · 14/18px pad · --panel #0C1219 · 1px #161F28 bottom divider · hover bg --surface-2 · whole row focusable	Click anywhere on the row opens Incident Detail for this incident.
20	Rank cell — 1	Mono 600 22px · #E6EDF3	Position in the ranking. Ranks are recomputed over the awaiting set only, so dispatching an incident renumbers everything below it.
21	Severity numeral — 3	Mono 700 18px inside a 48px dot · #E03127 fill · #FFFFFF numeral · 3px #FF8078 ring	Same colour and numeral pairing as the map marker.
22	Severity abbreviation chip — EXT	Mono 700 9px, .12em · #FF8078 on --halo · 1px solid #FF8078	Static.
23	Location — Simmons Creek Track	Sans 500 13.5px/1.3 · #D5DFE8 · ellipsised	Static.
24	Location meta	Same as #18	INC-0431 · -37.6602, 145.4211 · SAT — every row carries its incident id, coordinates and input channel.
25	Capture line	Mono 400 11px · #A8B6C2	captured 13:47 · 46 min ago. Relative age advances with the clock.
26	Why this position	Sans 400 13.5px/1.45 · #C4D0DA	Spotting 200 m ahead of the front will reach the plantation edge before the next pass.
27	Confidence figure — 0.88	Mono 600 12px · #35C46A	The model confidence against the fixed 0.75 threshold.
28	Confidence segments	Five 11×4px segments · filled in the confidence colour, empty #1B2731	Segment count = round(confidence / 20), minimum 1.
29	Distance — 11.4 km	Mono 600 13px · #C4D0DA	Distance from staging, the second sort key after severity.
30	Row action — Dispatch	Mono 600 10px, .12em, uppercase · #04191A on #2BD9C8 · 1px solid #2BD9C8 · 9/14px pad	Assigns a crew: the row leaves this section and reappears under LIVE / DISPATCHED, the status flag becomes Dispatched and the toast Crew dispatched to INC-0431 · Tanker 12 en route appears. The click is not stopped from the row, so pressing Dispatch also opens the incident detail screen — and the built green Dispatched button state is therefore unreachable (see Open items).
31	Row container — INC-0426	Same as #19	Click anywhere on the row opens Incident Detail for this incident.
32	Rank cell — 2	Same as #20	Position in the ranking. Ranks are recomputed over

#	Element	Visual spec	Behaviour / interaction
			the awaiting set only, so dispatching an incident renumbers everything below it.
33	Severity numeral — 3	Same as #21	Same colour and numeral pairing as the map marker.
34	Severity abbreviation chip — EXT	Same as #22	Static.
35	Location — Warrandale Rd culvert	Same as #23	Static.
36	Location meta	Same as #18	INC-0426 · -37.7130, 145.1907 · MANUAL — every row carries its incident id, coordinates and input channel.
37	Capture line	Same as #25	captured 13:31 · 1 hr 2 min ago. Relative age advances with the clock.
38	Why this position	Same as #26	Fire on both verges blocks heavy-vehicle access to everything north of the culvert.
39	Confidence figure — 0.83	Mono 600 12px · #F5C842	The model confidence against the fixed 0.75 threshold.
40	Confidence segments	Same as #28	Segment count = round(confidence / 20), minimum 1.
41	Distance — 18.9 km	Same as #29	Distance from staging, the second sort key after severity.
42	Row action — Dispatch	Same as #30	Assigns a crew: the row leaves this section and reappears under LIVE / DISPATCHED, the status flag becomes Dispatched and the toast Crew dispatched to INC-0426 · Tanker 12 en route appears. The click is not stopped from the row, so pressing Dispatch also opens the incident detail screen — and the built green Dispatched button state is therefore unreachable (see Open items).
43	Row container — INC-0419	Same as #19	Click anywhere on the row opens Incident Detail for this incident.
44	Rank cell — 3	Same as #20	Position in the ranking. Ranks are recomputed over the awaiting set only, so dispatching an incident renumbers everything below it.
45	Severity numeral — 2	Mono 700 15px inside a 37px dot · #F58021 fill · #1A0C02 numeral · 2px #FFB36B ring	Same colour and numeral pairing as the map marker.
46	Severity abbreviation chip — HIGH	Mono 700 9px, .12em · #FFB36B on --halo · 1px solid #FFB36B	Static.
47	Location — Kinglake NP eastern boundary	Same as #23	Static.
48	Location meta	Same as #18	INC-0419 · -37.5811, 145.0244 · MANUAL — every row carries its incident id, coordinates and input channel.
49	Capture line	Same as #25	captured 13:08 · 1 hr 25 min ago. Relative age advances with the clock.
50	Why this position	Same as #26	Perimeter unchanged across two submissions, and no assets sit inside the current spread.
51	Confidence figure — 0.90	Same as #27	The model confidence against the fixed 0.75 threshold.
52	Confidence segments	Same as #28	Segment count = round(confidence / 20), minimum 1.

#	Element	Visual spec	Behaviour / interaction
53	Distance — 26.5 km	Same as #29	Distance from staging, the second sort key after severity.
54	Row action — Dispatch	Same as #30	Assigns a crew: the row leaves this section and reappears under LIVE / DISPATCHED, the status flag becomes Dispatched and the toast Crew dispatched to INC-0419 · Tanker 12 en route appears. The click is not stopped from the row, so pressing Dispatch also opens the incident detail screen — and the built green Dispatched button state is therefore unreachable (see Open items).
55	Row container — INC-0402	Same as #19	Click anywhere on the row opens Incident Detail for this incident.
56	Rank cell — 4	Same as #20	Position in the ranking. Ranks are recomputed over the awaiting set only, so dispatching an incident rennumbers everything below it.
57	Severity numeral — 1	Mono 700 12px inside a 29px dot · #F5C842 fill · #1A1405 numeral · 2px #FFE08A ring	Same colour and numeral pairing as the map marker.
58	Severity abbreviation chip — MOD	Mono 700 9px, .12em · #FFE08A on --halo · 1px solid #FFE08A	Static.
59	Location — Old Mill Reserve	Same as #23	Static.
60	Location meta	Same as #18	INC-0402 · -37.8004, 145.2712 · API — every row carries its incident id, coordinates and input channel.
61	Capture line	Same as #25	captured 12:40 · 1 hr 53 min ago. Relative age advances with the clock.
62	Why this position	Same as #26	Smouldering debris on cleared ground with a sealed road on three sides.
63	Confidence figure — 0.94	Same as #27	The model confidence against the fixed 0.75 threshold.
64	Confidence segments	Same as #28	Segment count = round(confidence / 20), minimum 1.
65	Distance — 31.7 km	Same as #29	Distance from staging, the second sort key after severity.
66	Row action — Dispatch	Same as #30	Assigns a crew: the row leaves this section and reappears under LIVE / DISPATCHED, the status flag becomes Dispatched and the toast Crew dispatched to INC-0402 · Tanker 12 en route appears. The click is not stopped from the row, so pressing Dispatch also opens the incident detail screen — and the built green Dispatched button state is therefore unreachable (see Open items).
67	Row container — INC-0433	Grid 52 / 58 / 1fr / 1.5fr / 96 / 74 / 128px · 14px gap · 14/18px pad · --surface #0A0F15 · 1px #161F28 bottom divider · hover bg --surface-2 · whole row focusable	Click anywhere on the row opens Incident Detail for this incident. Flagged rows are shown for visibility but are not ranked and cannot be dispatched; their rank cell renders an em dash in #5C6B77.
68	Rank cell — ? (flagged, unranked)	Mono 700 13px · #2BD9C8	The rank column renders an em dash in #5C6B77 for a flagged row; the badge sits on the dashed accent “?” dot beside it, which is the element specified here. Flagged rows are never given a queue position.
69	Flag chip — REVIEW	Mono 700 9px, .12em · #2BD9C8 on accent @10% · 1px dashed #2BD9C8	Marks the row as awaiting a reviewer decision. The 34px dot beside it is dashed accent with a question mark.
70	Location — Unnamed track,	Same as #23	Static.

#	Element	Visual spec	Behaviour / interaction
	Bellbird Gully		
71	Location meta	Same as #18	INC-0433 · -37.6398, 145.3742 · DRONE — every row carries its incident id, coordinates and input channel.
72	Capture line	Same as #25	captured 14:11 · 27 min ago. Relative age advances with the clock.
73	Why this position	Same as #26	Smoke fills the frame, so no fire front is visible to rank against the others.
74	Confidence figure — 0.34	Mono 600 12px · #2BD9C8	The model confidence against the fixed 0.75 threshold.
75	Confidence segments	Same as #28	Segment count = round(confidence / 20), minimum 1.
76	Distance — 7.6 km	Same as #29	Distance from staging, the second sort key after severity.
77	Row action — Review	Mono 600 10px, .12em, uppercase · #2BD9C8 on accent @12% · 1px dashed #2BD9C8 · 9/14px pad	Opens this image in Manual Review instead of dispatching it. Flagged images cannot be dispatched.
78	Row container — INC-0435	Same as #67	Click anywhere on the row opens Incident Detail for this incident. Flagged rows are shown for visibility but are not ranked and cannot be dispatched; their rank cell renders an em dash in #5C6B77.
79	Rank cell — ? (flagged, unranked)	Same as #68	The rank column renders an em dash in #5C6B77 for a flagged row; the badge sits on the dashed accent “?” dot beside it, which is the element specified here. Flagged rows are never given a queue position.
80	Flag chip — REVIEW	Same as #69	Marks the row as awaiting a reviewer decision. The 34px dot beside it is dashed accent with a question mark.
81	Location — Broadwater pump station access	Same as #23	Static.
82	Location meta	Same as #18	INC-0435 · -37.6042, 145.2988 · MANUAL — every row carries its incident id, coordinates and input channel.
83	Capture line	Same as #25	captured 14:06 · 29 min ago. Relative age advances with the clock.
84	Why this position	Same as #26	Backlighting hides the flame edge and the exposure around the pump station.
85	Confidence figure — 0.41	Same as #74	The model confidence against the fixed 0.75 threshold.
86	Confidence segments	Same as #28	Segment count = round(confidence / 20), minimum 1.
87	Distance — 4.8 km	Same as #29	Distance from staging, the second sort key after severity.
88	Row action — Review	Same as #77	Opens this image in Manual Review instead of dispatching it. Flagged images cannot be dispatched.
89	Live section marker	7×7px square · #35C46A	Live signal.
90	LIVE / DISPATCHED · 1	Mono 600 10px, .14em, uppercase · #5FD98C · bar bg green @9%	Count rises to 1 the moment Dispatch is pressed.
91	Live section note	Same as #18	crew assigned · mark extinguished when the crew reports the fire out.
92	Row container — INC-0428	Same as #19	Click anywhere on the row opens Incident Detail for this incident.

#	Element	Visual spec	Behaviour / interaction
93	Rank cell — LIVE	Mono 600 10px/1.3, .1em, uppercase · #5FD98C	A dispatched incident has no queue position; the word LIVE occupies the rank cell.
94	Severity numeral — 4	Mono 700 21px inside a 58px dot · #7A0F16 fill · #FFFFFF numeral · 4px #FF4D4D ring	Same colour and numeral pairing as the map marker.
95	Severity abbreviation chip — CAT	Mono 700 9px, .12em · #FF4D4D on --halo · 1px solid #FF4D4D	Static.
96	Location — Ridge Rd, 3 km NE of Broadwater	Same as #23	Static.
97	Location meta	Same as #18	INC-0428 · -37.6214, 145.3087 · DRONE — every row carries its incident id, coordinates and input channel.
98	Capture line	Same as #25	captured 14:02 · 31 min ago. Relative age advances with the clock.
99	Why this position	Same as #26	Crew assigned. Stays live until the crew reports the fire out. The comparative ranking reason is dropped once the incident is no longer ranked.
100	Confidence figure — 0.92	Same as #27	The model confidence against the fixed 0.75 threshold.
101	Confidence segments	Same as #28	Segment count = round(confidence / 20), minimum 1.
102	Distance — 3.2 km	Same as #29	Distance from staging, the second sort key after severity.
103	Row action — Extinguished	Mono 600 10px, .12em, uppercase · #C4D0DA · transparent · 1px solid #42525F · 9/14px pad · hover bg --surface-2	Records the crew's report: the flag becomes Extinguished with the time, who and the note Crew reported the fire out, the incident leaves this order and is listed under Resolved, the change is logged, and a toast offers Undo. This button stops the click from reaching the row, so it does not navigate.
104	Threshold footnote badge	29px circle · 2px dashed #2BD9C8 · Mono 700 11px #2BD9C8 question mark	Marker for the footnote.
105	Threshold footnote — 0.75	Sans 400 12.5px/1.4 · #8B9AA8 (figure inline)	Unchanged from the awaiting state.

4 · Open items — do not treat as resolved

Every item below is either an audit finding marked partial or missing in section 1, or a known-open question carried forward. None of them is resolved by this document.

1. "Extinguished" is not resolved as a model label, a coordinator action, or both

In the build it behaves purely as a coordinator action on a dispatched incident: only an incident with a crew assigned can be marked extinguished, the mark carries "EC · Emergency Coordinator" and "Crew reported the fire out", and Reopen returns it to the live section. But the same word is also used as a CLASSIFICATION LABEL value on Incident Detail (Fire / Non-Fire / Extinguished / Uncertain), which reads as a model output. Whether the model can ever emit "Extinguished" from an image — for example a burnt-out scene with no active fire — is unresolved, and the two readings need one owner. Do not treat this as settled.

Working assumption (Week 1, Sprint 2): the product is coordinator-facing only — no platform exists for a dispatch crew to report a fire out directly — so Extinguished is built and treated as a coordinator action taken on the crew's real-world report, not as something the model classifies from an image. This does not resolve whether the model itself is expected to recognize and classify a burnt-out scene as Extinguished from an image, which remains an open design question. Pending team discussion; not a final decision.

2. Whether flagged and dismissed images are removed from the map or only hidden from the default view

Built behaviour: images with no applied severity (flagged) and images dismissed as not a fire are both excluded from the map's marker set entirely — there is no filter that brings them back. The only map-side acknowledgement of flagged images is the "n flagged · not drawn on the map until reviewed" strip in the rail. Extinguished incidents are different: they are hidden from the default view but retrievable through the "Extinguished" filter, where they draw at 45% opacity with a dashed ring and an OUT chip. Whether flagged and dismissed images should also be retrievable on the map under a filter is an open decision.

3. Override toast dismissal — matches the ~5 s spec, with three additions to confirm

The toast auto-clears on a 5 s timer and shows a 5 s draining bar with the caption "clears in 5s · dismiss sooner with X", so the specified behaviour is met. Three deviations to confirm: (a) the toast is also cleared early by navigation — opening any incident or review item removes it, which silently removes the Undo affordance; (b) pressing Undo inside the toast does not raise any confirmation that the revert happened, it simply removes the toast; (c) the Undo CTA is replaced by "Dismiss" for dispatch and "second image requested" toasts, so not every toast is undoable. Treat the 5 s figure as confirmed and the early-clear-on-navigation as unspecified.

4. Manual Review has five reviewer controls, not three

In addition to Confirm, Change and Discard, the screen carries "Request second image" and "Locate on map". Neither changes the image's state, but both occupy the same decision card and are visually equal to Discard. "Locate on map" is also currently inconsistent: it switches to the map and pulses the image's marker, but a flagged image has no marker until it is confirmed. Needs a decision: keep them as secondary utilities (visually demoted), or remove them.

5. "Change" is four buttons rather than one action

The specified "Change" action is built as four severity chips (CAT / EXT / HIGH / MOD) plus four "?" explainers, with no confirm step. That is faster than a two-step change, but it means eight controls sit between Confirm and Discard, and there is no way for a reviewer to change the severity and keep the image in review. Confirm the interaction model before build.

6. Confirm and Change navigate away; Discard does not

Confirm and Change both jump to Incident Detail for the promoted incident. Discard stays in Manual Review and silently advances to the next queue item. Both are defensible; they are not consistent with each other, and a reviewer working a queue of ten will experience two different flows. Needs a decision.

7. Coordinator-set severity discards the four sub-scores

When a reviewer uses Change, or a coordinator overrides a confirmed incident, the four element scores are set to null and the detail screen shows "— not scored" with the chip "COORDINATOR". The original model sub-scores are not preserved anywhere in the UI, and the exportable record writes smoke=null flame=null damage=null people=null sum=null. If the model's original scoring needs to survive a human override for audit or retraining, that is a data-model change, not a UI change.

8. No clustering is visible at the default zoom

Clusters are defined only for Z1 and Z2 as fixed lists of incident IDs, and a cluster draws only when at least two of its members are currently visible. The single Z2 cluster pairs INC-0428 with INC-0435, which is flagged and therefore never drawn, so the default (Z2) view shows five individual markers and no cluster. Clustering is also not computed from proximity — it is authored per zoom level. Both need to be specified properly before build: what the real clustering rule is (pixel distance? geographic radius? per-zoom grid?) and what happens to a cluster whose members are partly flagged.

9. Pressing Dispatch on a row also navigates to Incident Detail

The row's Dispatch button does not stop the click from reaching the row, so one press both assigns the crew and leaves the dispatch order for the detail screen. The Extinguished button in the live section does stop propagation, so the two behave differently. Also unreachable as a result: the built green "Dispatched" button state, because the row relocates to the live section immediately.

10. The decision log is per-incident only

Every override, confirmation, manual assignment, dismissal, restore, grouping decision, dispatch cancellation, extinguish, reopen and undo is written with the original value, the new value, who and when — but the only place any of it is visible is the DECISION LOG block on that one incident's detail screen. There is no shift log, no export, and no way to answer "what did this coordinator change in the last hour". If an audit view is in scope, it is unbuilt.

11. Dismissed and extinguished chips are nearly identical

DISMISSED (#5C6B77 text, 1 px #2C3A48) and EXTINGUISHED (#D5DFE8 text, 1 px #42525F) sit on the same --surface-3 ground at the same 9 px size. They are only ever seen on separate screens in the current build, so the difference is not load-bearing yet; it would be if the two lists are ever merged, or if either chip appears in a shared feed.

12. Grouping is one hardcoded proposal, and split is all-or-nothing

The prototype contains exactly one group (GRP-04, three members, "within 1.2 km and 9 minutes") whose proximity and time-window figures are fixed strings. Confirm and Keep separate work as a real state machine, but there is no way to remove a single member from a proposal, no way to merge two confirmed groups, and no second proposal to test against. The build also defers, by its own note, what happens to a confirmed group after a member's severity is overridden.

13. Resolved rows have no dispatch timestamp

The DISPATCHED column renders the fixed string "this shift" because no dispatch time is recorded when a crew is assigned. Response-time reporting would need that timestamp captured at dispatch.

14. Fixed values that look like data

"Tanker 12 en route" (dispatch toast), "model v0.3", "SUB-2291" (submission reference), "SECTOR 7 · VIC", the 0.75 threshold (exposed as a prop, default 75%), and the 1.2 km / 9 minute grouping window are all hardcoded in the prototype. None should be read as a decided value.

15. Accessibility items carried but unresolved

Keyboard operation is built in (skip link, Tab order, Enter/Space on every div-button, </> between screens, Alt/Option+1–6, ? for the shortcut sheet, Esc, focus outlines at 2 px accent). Two things remain: the smallest type in the system is 9 px mono on the severity abbreviation chips and status chips, and controls are div elements with role="button" rather than real buttons, so screen-reader and assistive-tech behaviour has not been verified.

16. Submit Image: the required-field hint never updates

The status line beside the submit button reads "3 required fields" whether the form is empty, partly filled or complete. It only changes when a submission is running, to "do not close this tab". A developer should not infer a live validation counter from it — as built it is a static string in two states.

17. Submit Image: the form is not locked while an assessment runs

During the processing state the submit button correctly disables and relabels to "Assessing image...", but the four inputs, the image drop zone, "Use device location", "Use current time" and "Clear" all stay live. Pressing Clear mid-assessment empties the form while the submission continues in the background. Whether the form should freeze, or a second submission should be queued, is unspecified.

18. Submit Image: file handling is simulated

The drop zone does not open a file picker; clicking it fills a fixed file name (IMG_4475.jpg) with fixed metadata (2.4 MB · JPEG). The "JPEG or PNG · max 15 MB" limit is stated but not enforced anywhere, and the submission reference SUB-2291 is a fixed string. None of these should be read as decided behaviour.

19. Submit Image: the input-source row is display-only

All four channels (manual upload, drone, satellite, bulk API) are listed with MANUAL marked as active, but the row is not a selector — the prototype has no way to submit as a different channel. The per-incident source chip elsewhere in the app is populated from the seeded data, not from this screen.

20. Submit Image: the four demo buttons are prototype scaffolding

"Demo: submit without geotag", "Demo: fill valid submission", "Demo: low-confidence result" and "Demo: not-a-fire result" exist to drive the prototype's states for review. They are not product UI and must not be built.

21. Manual Review's provisional-tag layout assumes severity scoring always ran — it may not, for gate-level-uncertain items

Per the Sprint 2 BA doc, severity scoring only runs once the fire/non-fire gate passes at 0.75 confidence or higher with a Fire result. If the gate itself is uncertain, the incident goes to Manual Review without ever being scored — no provisional band, no element scores, no severity confidence exist for it. The provisional-tag card as built (and as annotated in this document) always shows a provisional band, four element scores and a confidence figure, which only matches the severity-stage-uncertain path. Whether gate-uncertain items need a second, simpler Manual Review layout is unresolved — carried to Sprint 2 Week 2 for team discussion, not to be treated as decided by this document.

5 · Anticipated questions

What a developer should double-check with UX before starting

Six things. (1) Where the reviewer lands after each of the three Manual Review actions — today Confirm and Change leave the screen and Discard does not. (2) Whether "Change" is really four one-click chips with no confirm step, and whether the two extra controls on that screen (Request second image, Locate on map) are in scope at all. (3) What the real map clustering rule is, since the built one is an authored per-zoom list and produces no cluster at the default zoom. (4) Whether the model's four sub-scores must survive a human override — the UI currently nulls them. (5) Whether a cross-incident audit view is in scope; the log data is complete but only ever shown one incident at a time. (6) Whether flagged and dismissed images need a way back onto the map, as extinguished incidents have.

The one thing in this document most likely to be wrong or to need a client / BA decision

The meaning of "Extinguished". This document records what the prototype does — only a coordinator can mark a dispatched incident extinguished — but the same word is also offered as a classification label alongside Fire, Non-Fire and Uncertain, which implies the model can produce it. Those two readings drive different builds: one is a lifecycle state owned by the coordinator, the other is a model output that would need its own confidence handling and its own route into the Resolved list. This needs a client or BA decision before the Resolved screen is built, and it is the item most likely to change other parts of this document.

How to read the annotations

Numbers on each screenshot correspond to the numbered rows in the table directly below it. Where a table row covers a range ("13–20"), the same specification applies to each numbered element in that range. Where a table row is marked "—", it documents behaviour or a state that is real but not visible in that screenshot. Colour values are the built values in the dark (default) theme; the light-theme equivalents are in section 1. Anything described in section 3 is unresolved and should not be built from this document without a decision.